

KANSAS

Form 51-5M-7-40-Palace


Ellis

Section 21 Township 11 Range 17-W

Well No. #3 Hadley

Company Winkler & Koch

NORTH Bemis Pool

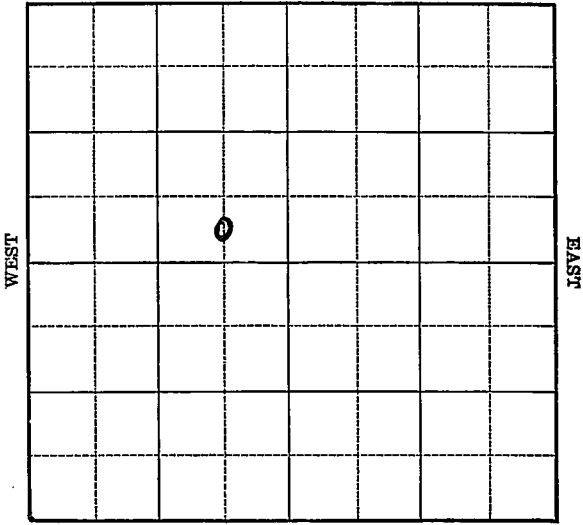

Sec. 21 Twp. 11 R. 17-W

Well No. #3 Hadley Farm

Winkler & Koch Company

(Bemis)


_____ Ft. from N. Line

330 Ft. from S. Line

660 Ft. from E. Line

_____ Ft. from W. Line

Elev. 1862

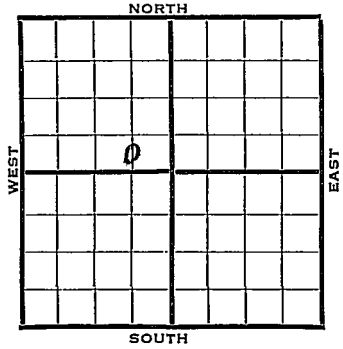

1940	REPORT
7/31	Cellar & Pits.
8/8	13" - 100' WOC.
8/14	Anhy 1075-Drlg. 2060'
8/22	Drlg. 3157'
8/29	Arb. 3364' 7" - 3364'
	T.D. 3371' 2750' oil.
9/4	Arb. 3364'
	7" - 3364'
	T.D. 3371'
	2000 acid.
	Depthograph potential 3220 bbls.
	Maximum 3000 bbls.
	COMPLETED

Map No. 71 Sec. 21 Twp. 11 R. 17WWell No. 3 HadleyWinkler & Koch

Company

Contractor

FIRST REPORT

C S $\frac{1}{2}$ SE NW Ft. from N. Line330 Ft. from S. Line660 Ft. from E. Line Ft. from W. Line

SECTION PLAT

	0		

BEMIS POOL

Location Rig up

Drilling and Remarks:

Cel. & Pits

RECORD

Cased in., ft.Sand Gas Oil Total Depth

PRODUCTION

1st 24 hrs. Nat. 1st 24 hrs. after shot Gas Cu. Ft.Dry Hole Abandoned

Date

JUL 31 1940 19S. J. LEWIS Scout

Map No. _____ Sec. 21 Twp. 11 R. 17WWell No. 3 HadleyWinkler & Koch

Company

Contractor

COMPLETEDC $S\frac{1}{2}$ SE NW

_____ Ft. from N. Line

330 Ft. from S. Line660 Ft. from E. Line

_____ Ft. from W. Line

BEMIS POOL

SECTION PLAT

Location _____

Rig up _____

Drilling and Remarks:

*Cr & 3364**7" @ 3364**2000 acid**Depthograph log
3220**May 3000***RECORD**

Cased _____ in., _____ ft.

Sand _____

Gas _____

Oil _____

Total Depth 3371**PRODUCTION**

1st 24 hrs. Nat. _____

1st 24 hrs. after shot _____

Gas _____ Cu. Ft.

Dry Hole _____

Abandoned _____

Date

SEP 4 1940S. J. LEWIS Scout