

Ellis


FORM 51 IOM 12-46 PETROL

~~KANSAS~~

Section 21 Township 11 Range 17-W

Well No. #5 Hadley

Company Eldorado Ref.
Bemis

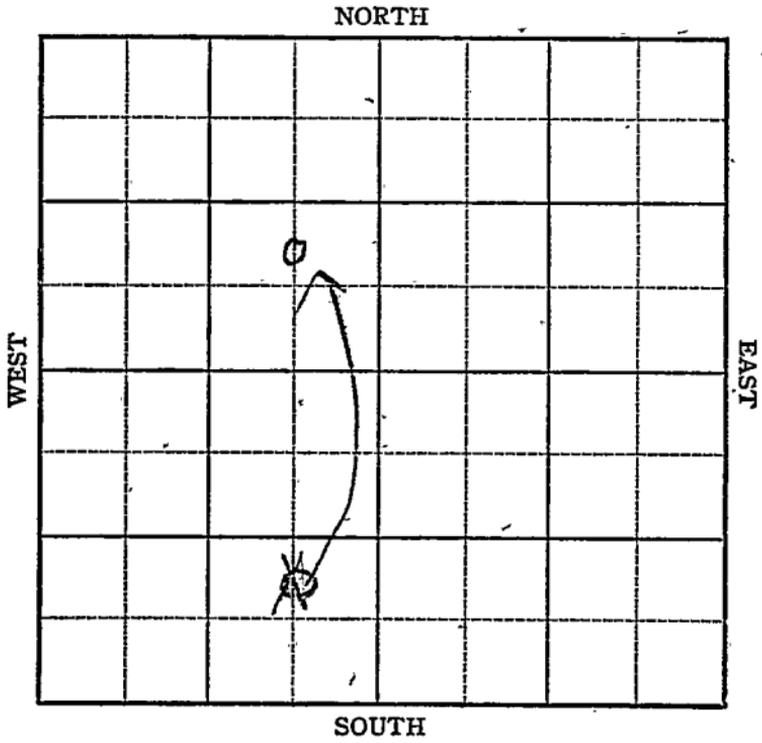



Sec. 21 Twp. 11 R. 17-W

Well No. # 5 Hadley Farm

Eldorado Ref. Company


Bermis Pool

_____ Ft. from N. Line

990 Ft. from S. Line

660 Ft. from E. Line

_____ Ft. from W. Line

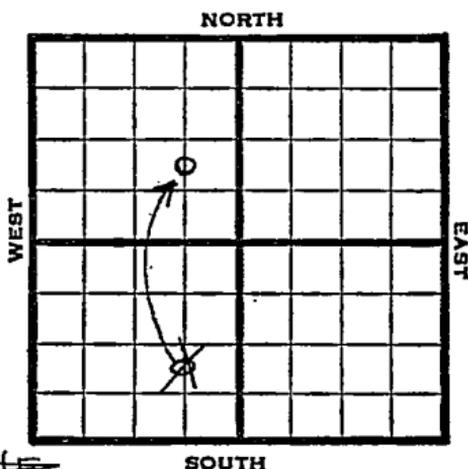

~~C N L SE SW~~
~~CNL SE-NW, NE-NW-NE~~

1947

REPORT

Elev 1836'

6/18 Location

6/24 8" @ 1072'
Drlg 3005'

7/1 Lansing 3048'
Arbuckle 3352'
TD 3355
5" @ 3353
RUST

7/8 1600' fluid 1 1/2 hrs
1/3 water

7-16 "

7/22 "

7/29 "

8/6 "

8/13 "

8/20 Arb. 3352'
5" @ 3363'
Pump 279' oil / 24% W Pot.
Gr. 36
T.D. 3355'
Complete.

COMPLETED

Map No. _____ Sec. 21 Twp. 11 R. 17W

Well No. 5 Hadley

Eldorado Ref. Company

FIRST REPORT

Contractor

C N L SE SW

SECTION PLAT

_____ Ft. from N. Line

990 Ft. from S. Line

660 Ft. from E. Line

_____ Ft. from W. Line

Ellis County

Location X

Rig up _____

Drilling and Remarks:

RECORD

Cased _____ in., _____ ft.

Sand _____

Gas _____

Oil _____

Total Depth _____

PRODUCTION

1st 24 hrs. Nat. _____

1st 24 hrs. after shot _____

Gas _____ Cu. Ft.

Dry Hole _____

Abandoned _____

Date

JUN 18 1947 19

S. J. LEWIS Scout