Ellis


KANSAS

Form 51-5M 5-37 Petrol

Section 21 Township 11 Range 17-W

Well No. 1 Bemis

Company Republic

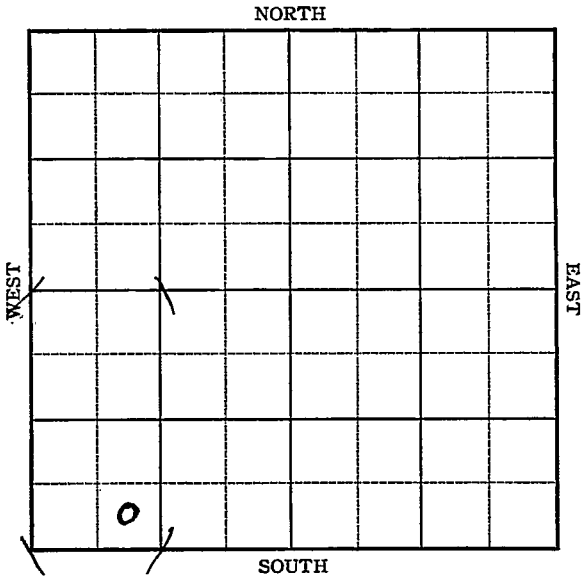


Form 252-A—5M—9-37 KANSAS Ellis

Sec. 21 Twp. 11 R. 17-W

Well No. #1 Bemis Farm

Republic Company

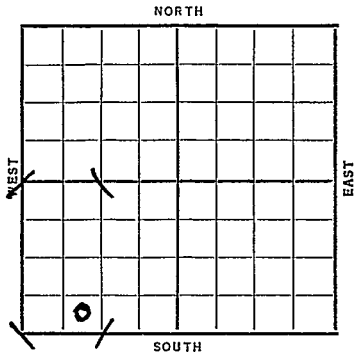

Ft. from N. Line

330 Ft. from S. Line

Ft. from E. Line

990 Ft. from W. Line

Elev. 1963

Date	REPORT
1937	
12/15	R U R
12/24	15" @ 65'. Anhy 1170'.
	10" @ 1179'. WOC.
12/31	Drlg. 2470'.
1938	
1/7	Drlg. 3360'.
1/14	Arb. 3369'. T.D. 3371'.
	7" @ 3368'. No shows reported.
1/19	7" @ 3468'.
	Arb. 3468' (Corrected)
	T.D. 3473'.
	Potential 1520 bbls. Nat.
	COMPLETED

Form 26—1M Bks.—2-29 Ellis KANSAS

Map No. 71 Sec. 21 Twp. 11 R. 17W

Well No. 1 Bemis

Republic Company

FIRST REPORT Contractor

SE SW SW


_____ Ft. from N. Line

330 Ft. from S. Line

_____ Ft. from E. Line

990 Ft. from W. Line

SECTION PLAT

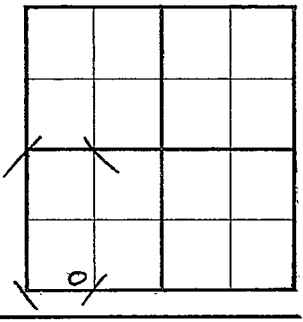

Location _____

Rig up _____

Drilling and Remarks:

RUR

RECORD

Cased _____ in., _____ ft.

Sand _____

Gas _____

Oil _____

Total Depth _____

PRODUCTION

1st 24 hrs. Nat. _____

1st 24 hrs. after shot _____

Gas _____ Cu. Ft.

Dry Hole _____

Abandoned _____

Date

DEC 15 1937 19____ H. D. Hatfield Scout

Form 26—1M Bks.—2-29

Ellis KANSAS

Map No. 71 Sec. 21 Twp. 11 R. 17W

Well No. 1 Bemis

Republic Company

Contractor

COMPLETED

SE SW SW


Ft. from N. Line

330 Ft. from S. Line

Ft. from E. Line

990 Ft. from W. Line

SECTION PLAT

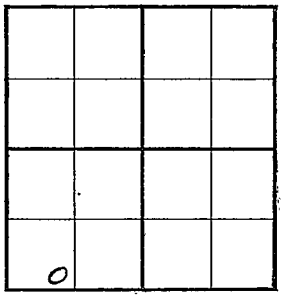

Location

Rig up

Drilling and Remarks:

Pot - 1520

Nat.

RECORD

Cased 7 in., 3468 ft.

~~Sand~~ Ark 3468'

Gas (Corr)

Oil

Total Depth 3473

PRODUCTION

1st 24 hrs. Nat.

1st 24 hrs. after shot

Gas Cu. Ft.

Dry Hole

Abandoned

Date

JAN 19 1938 19

E. D. Hatfield Scout