


Form 51-5M 5-37 Petrol **Ellis**

Section 21 Township 11 Range 17-W

Well No. 14 Bemis

Company Cities Service Oil

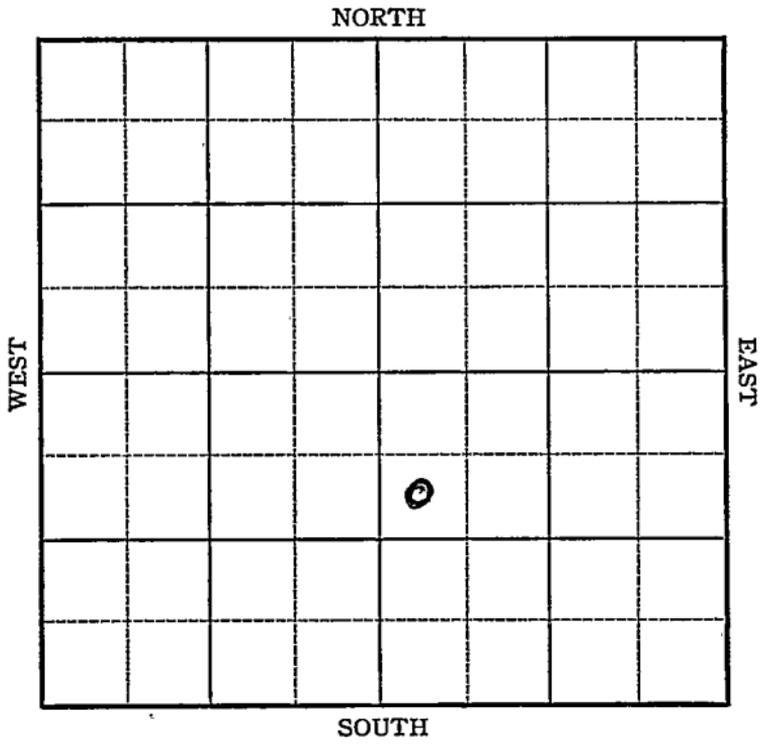

Sec. 21 Twp. 11 R. 17-W

Well No. #14 Bemis Farm
Cities Service Oil Company


990 Ft. from N. Line

_____ Ft. from S. Line

_____ Ft. from E. Line

330 Ft. from W. Line

Elev. 1883

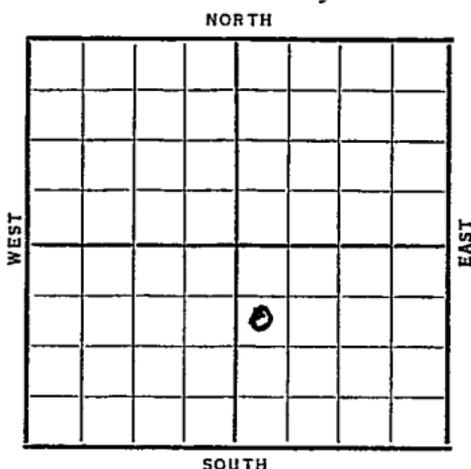

Date	REPORT
1937	
11/23	Location
12/3	B. R. R.
12/10	R U R
12/17	15" @ 108'. Drlg. 615'.
12/24	10" @ 1096'. Drlg. 2175'.
12/30	Drlg. 3250'.
1938	
1/7	Simp. 3352'. Arb. 3371'.
	7" @ 3372'. RUST. S.O.
1/14	T.D. 3382'. 2700' oil.
1/19	7" @ 3372'.
	Arb. 3371'.
	T.D. 3382'.
	Potential 2093 bbls. Nat.
	COMPLETED

Map No. 7 Sec. 21 Twp. 11 R. 17WWell No. 14 BemisCities Service Oil

Company

Contractor

FIRST REPORT

SW NW SE

990 Ft. from N. Line

_____ Ft. from S. Line

_____ Ft. from E. Line

330 Ft. from W. Line**SECTION PLAT**

		0	

Location X

Rig up _____

Drilling and Remarks:

RECORD

Cased _____ in., _____ ft.

Sand _____

Gas _____

Oil _____

Total Depth _____

PRODUCTION

1st 24 hrs. Nat. _____

1st 24 hrs. after shot _____

Gas _____ Cu. Ft.

Dry Hole _____

Abandoned _____

Date

NOV 23 1937 19H. D. Hatfield

Scout

Ellis

Map No. 71 Sec. 21 Twp. 11 R. 17W

Well No. 14 Bemis

Cities Service Oil Company

Contractor

COMPLETED

SW NW SE

990 Ft. from N. Line

_____ Ft. from S. Line

_____ Ft. from E. Line

330 Ft. from W. Line

SECTION PLAT

		0	

Location _____

Rig up _____

Drilling and Remarks:

POT 2093
N21

RECORD

Cased 7 in., 3372ft.

Sand Arb 3371

Gas _____

Oil _____

Total Depth 3382

PRODUCTION

1st 24 hrs. Nat. _____

1st 24 hrs. after shot _____

Gas _____ Cu. Ft.

Dry Hole _____

Abandoned _____

Date

JAN .19 1938

19

H. D. Hatfield

Scout