


Ellis

Section 21 Township 11 Range 17-W

Well No. 12 Bemis

Company Cities Service Oil

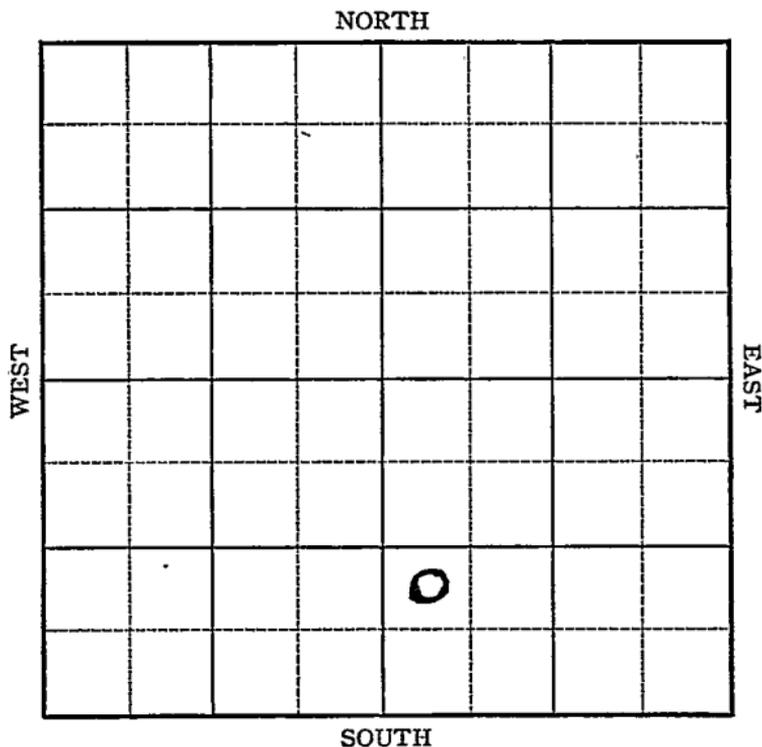

Sec. 21 Twp. 11 R. 17-W

Well No. #12 Bemis Farm


Cities Service Oil Company

\_\_\_\_\_ Ft. from N. Line

990 Ft. from S. Line

\_\_\_\_\_ Ft. from E. Line

330 Ft. from W. Line

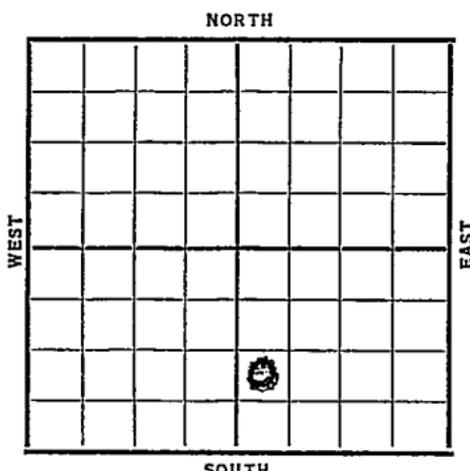

Elev. 1891

Date	REPORT
1937	
9/1	Location
9/10	B.R.R.
9/17	S. H.
9/24	15" @ 94'. Anhy 1105'.
	10" @ 1109'. Drlg. 1760'.
10/2	Drlg. 2954'.
10/8	Sil. 3377'. 7" @ 3378'.
	T.D. 3379'. RUST.
10/15	Sil. & 7" @ 3375' (Corrected)
	T.D. 3395'. 2800' oil.
10/20	15" @ 94'.
	10" @ 1109'.
	7" @ 3375'.
	Sil. 3375' (Corrected)
	T.D. 3400'.
	Pot. 2416 bbls. Nat.
	<b>COMPLETED</b>

Ellis KANSAS

Map No. 71 Sec. 21 Twp. 11 R. 17WWell No. 12 - Bemis  
Cities Service Co. Company

Contractor

## FIRST REPORT

## SECTION PLAT

     Ft. from N. Line990 Ft. from S. Line     Ft. from E. Line330 Ft. from W. Line

		0	

Location Rig up     

Drilling and Remarks:

## RECORD

Cased      in.,      ft.Sand     Gas     Oil     Total Depth     

## PRODUCTION

1st 24 hrs. Nat.     1st 24 hrs. after shot     Gas      Cu. Ft.Dry Hole     Abandoned     

Date

SEP 1 1937 19

H. D. H. Scout

Ellis

KANSAS

Map No. \_\_\_\_\_ Sec. 21 Twp. 11 R. 17WWell No. 12 BemisCities Service Oil Company

Contractor

COMPLETED

NW SW SE

\_\_\_\_\_ Ft. from N. Line

990 Ft. from S. Line

\_\_\_\_\_ Ft. from E. Line

330 Ft. from W. Line

SECTION PLAT

		0	

Location \_\_\_\_\_

Rig up \_\_\_\_\_

Drilling and Remarks:

POT-2416NAT15" - 9410" RECORD 1109Cased 7 in., 3375 ft.Sand Sil 3375Gas (Corrected)

Oil \_\_\_\_\_

Total Depth 3400

PRODUCTION

1st 24 hrs. Nat. \_\_\_\_\_

1st 24 hrs. after shot \_\_\_\_\_

Gas \_\_\_\_\_ Cu. Ft.

Dry Hole \_\_\_\_\_

Abandoned \_\_\_\_\_

Date

OCT 21 1937 19H. D. Hatfield Scout