
FORM 51 5M 2-38 TPCO. Ellis

KANSAS

Section 21 Township 11 Range 17-W

Well No. #2 Bemis

Company Republic Nat.

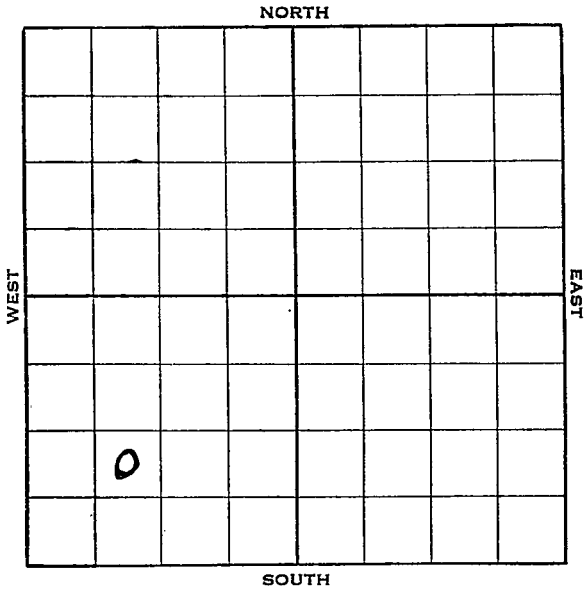


Form 252-A—5M—9-37 KANSAS Ellis

Sec. 21 Twp. 11 R. 17-W

Well No. #2 Bemis Farm

Republic Nat. Company

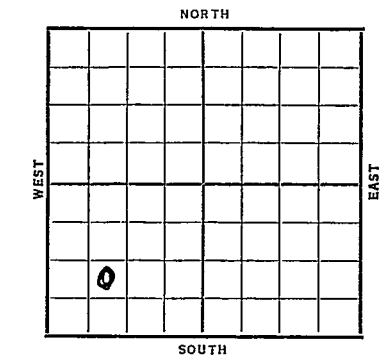

____ Ft. from N. Line

990 Ft. from S. Line

____ Ft. from E. Line

990 Ft. from W. Line

Elev. 1946

Date	REPORT
1938	
3/23	15" @ 65'. Anhy. 1158'.
	10" @ 1162'. WOC.
4/1	Drlg. 2430'.
4/8	Arb. 3458'. Rng. pipe?
4/15	7" @ 3458'. T.D. 3460'.
	RUST.
4/22	2000' oil. Testing.
4/27	7" @ 3458'.
	Arb. 3458',
	T.D. 3460'.
	Potential 2434 bbls., Nat'l.
	COMPLETED

Form 26—1M Bks.—2-29 Ellis KANSAS

Map No. 21 Sec. 21 Twp. 11 · R. 17W

Well No. 2 Bemis

Republic Nat. Company

Contractor

FIRST REPORT

NE SW SW


Ft. from N. Line

990 Ft. from S. Line

Ft. from E. Line

990 Ft. from W. Line

SECTION PLAT

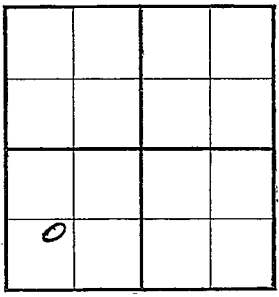

Location

Rig up.

Drilling and Remarks:

15" - 65

Anhy. 1158

10" 1162

WOC

RECORD

Cased in., ft.

Sand

Gas

Oil

Total Depth

PRODUCTION

1st 24 hrs. Nat.

1st 24 hrs. after shot

Gas Cu. Ft.

Dry Hole

Abandoned

Date

MAR 23 1938 19 H. D. Hatfield Scout

Form 26—1M Bks.—2-29

Ellis KANSAS

Map No. 71 Sec. 21 Twp. 11 R. 17W

Well No. 2 Bemis

Republic Company

Contractor

COMPLETED

NE SW SW


____ Ft. from N. Line

990 Ft. from S. Line

____ Ft. from E. Line

990 Ft. from W. Line

SECTION PLAT

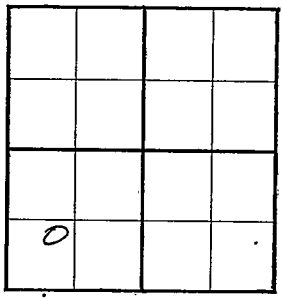

Location ____

Rig up ____

Drilling and Remarks:

Pot 2434

NAT

RECORD

Cased 7 in., 3458 ft.

~~Sand~~ Arb 3458

Gas ____

Oil ____

Total Depth 3460

PRODUCTION

1st 24 hrs. Nat. ____

1st 24 hrs. after shot ____

Gas ____ Cu. Ft.

Dry Hole ____

Abandoned ____

Date

APR 27 1938 19____

~~H. D. Hatfield~~ Scout