


Section 21 Township 11 Range 17-W

Well Number #2 Bemis

Company Empire

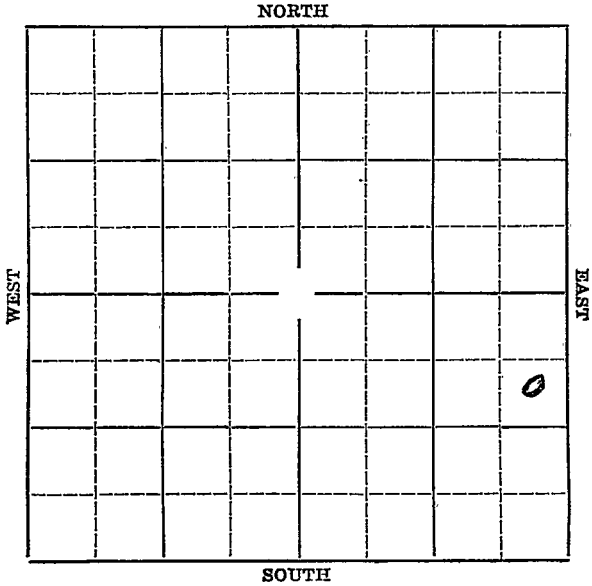

KANSAS

Sec. 21 Twp. 11 R. 17W

Well No. #2 Bemis Farm

Empire Company


990' Ft. from N. Line

_____ Ft. from S. Line

330' Ft. from E. Line

_____ Ft. from W. Line

Elev. 1922

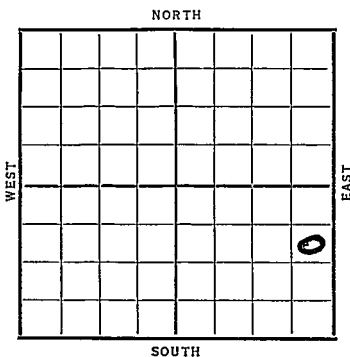

Date	REPORT
10/21	Location.
10/29	Rig.
11/6	15" @ 104 WOC
11/12	10" @ 1130'. T. D. 1150' WOC
11/19	Drlg. 2320'.
11/27	Drlg. 3180'.
12/3	Sil. 3418'. Set 7".
	T. D. 3422'. Rust.
12/10	2800' oil 1½ hrs.
12/16	Sil. 3419'. T. D. 3441'.
	Pot. 2270'.
	COMPLETED

Map No. 71 Sec. 21 Twp. 11 R. 17W

Well No. 2 Bemis

Empire Company

Contractor

SECTION PLAT

			O

990 Ft. from N. Line

_____ Ft. from S. Line

380 Ft. from E. Line

_____ Ft. from W. Line

FIRST REPORT

Location ✓

Rig up _____

Drilling and Remarks:

RECORD

Cased _____ in., _____ ft.

Sand _____

Gas _____

Oil _____

Total Depth _____

PRODUCTION

1st 24 hrs. Nat. _____

1st 24 hrs. after shot _____

Gas _____ Cu. Ft.

Dry Hole _____

Abandoned _____

Date

OCT 21 1936

S. J. LEWIS Scout

KANSAS

Map No. 71 Sec. 21 Twp. 11 R. 17W

Well No. 2-Bemis

Empire Company

Contractor

SECTION PLAT

990 Ft. from N. Line

_____ Ft. from S. Line

330 Ft. from E. Line

_____ Ft. from W. Line

			o

COMPLETED

Location _____

Rig up _____

Drilling and Remarks:

Sil 3419

P.O. 2270

RECORD

Cased _____ in., _____ ft.

Sand _____

Gas _____

Oil _____

Total Depth 3441

PRODUCTION

1st 24 hrs. Nat. _____

1st 24 hrs. after shot _____

Gas _____ Cu. Ft.

Dry Hole _____

Abandoned _____

Date

DEC 16 1936 19

S. J. LEWIS

Scout