


Section.....21.....Township.....11.....Range.....17..W

Well Number.....10 - Bemis.....


Company.....Empire.....

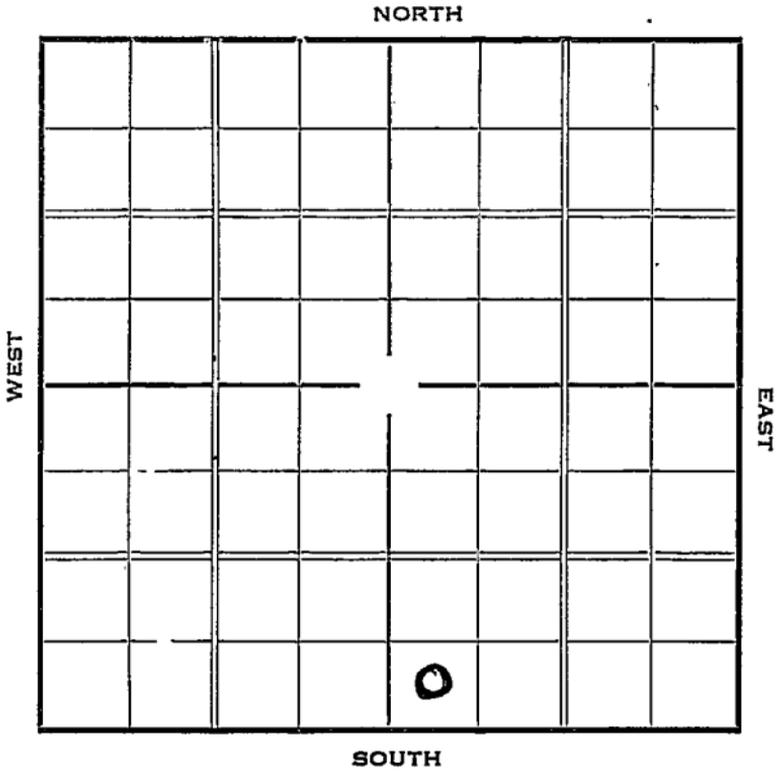

Sec. 21 Twp. 11 R. 17-~~W~~

Well No. #10 Bemis Farm  
Empire Company

\_\_\_\_\_ Ft. from N. Line  
330 Ft. from S. Line  
 \_\_\_\_\_ Ft. from E. Line  
330 Ft. from W. Line  
 Elev. 1886

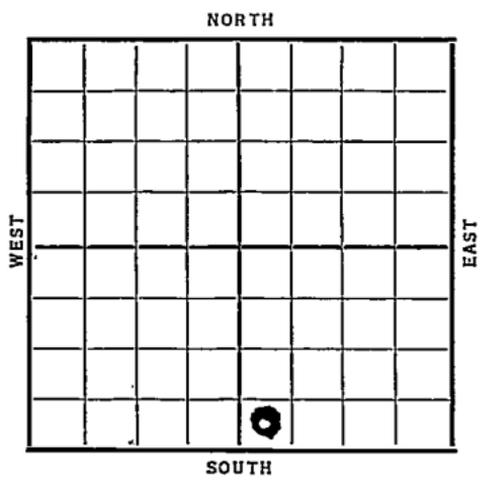

Date	REPORT
1937	
6/23	Location
7/2	"
7/9	Rig
7/16	"
7/23	"
7/30	"
8/6	R U R
8/13	10" @ 1101'. Drlg. 1495'.
8/20	Fsg. 2904'.
8/28	Sil. & 7" @ 3374'. RUST.
9/3	" " " " "

**OVER**

1937

9/8

7<sup>m</sup> @ 3374'.

Sil. 3374'.

T.D. 3384'.

P. 337.5 bbls. 4 hrs.

P. 340.2 bbls. 4 hrs.

Potential 2025 bbls.

COMPLETED

Ellis KANSAS

Map No. 71 Sec. 21 Twp. 11 R. 17<sup>w</sup>Well No. 10-BenusEmpire Company

Contractor

## FIRST REPORT

## SECTION PLAT

\_\_\_\_\_ Ft. from N. Line

330 Ft. from S. Line

\_\_\_\_\_ Ft. from E. Line

330 Ft. from W. Line

		0	

Location \_\_\_\_\_

Rig up \_\_\_\_\_

Drilling and Remarks:

## RECORD

Cased \_\_\_\_\_ in., \_\_\_\_\_ ft.

Sand \_\_\_\_\_

Gas \_\_\_\_\_

Oil \_\_\_\_\_

Total Depth \_\_\_\_\_

## PRODUCTION

1st 24 hrs. Nat. \_\_\_\_\_

1st 24 hrs. after shot. \_\_\_\_\_

Gas \_\_\_\_\_ Cu. Ft.

Dry Hole \_\_\_\_\_

Abandoned \_\_\_\_\_

Date

JUN 23 1937 19

H. D. Hatfield  
Scout

Map No. \_\_\_\_\_ Sec. 21 Twp. 11 R. 17W

Well No. 10 - Bemis

Empire Company

Contractor \_\_\_\_\_

**COMPLETED**

**SECTION PLAT**

\_\_\_\_\_ Ft. from N. Line

330 Ft. from S. Line

\_\_\_\_\_ Ft. from E. Line

330 Ft. from W. Line

		0	

Location \_\_\_\_\_

Rig up \_\_\_\_\_

Drilling and Remarks:

P. 337.5 4 hrs  
340.2 " "

Pat 2025 Hla

**RECORD**

Cased, 7 in., 3374 ft.

3374 3374

Gas \_\_\_\_\_

Oil \_\_\_\_\_

Total Depth 3384

**PRODUCTION**

1st 24 hrs. Nat. \_\_\_\_\_

1st 24 hrs. after shot \_\_\_\_\_

Gas \_\_\_\_\_ Cu. Ft.

Dry Hole \_\_\_\_\_

Abandoned \_\_\_\_\_

Date

SEP 8 1937 19

H. D. Hatfield

Scout