


Section 21 Township 11 Range 17-W

Well Number 5 Bemis

Company Empire

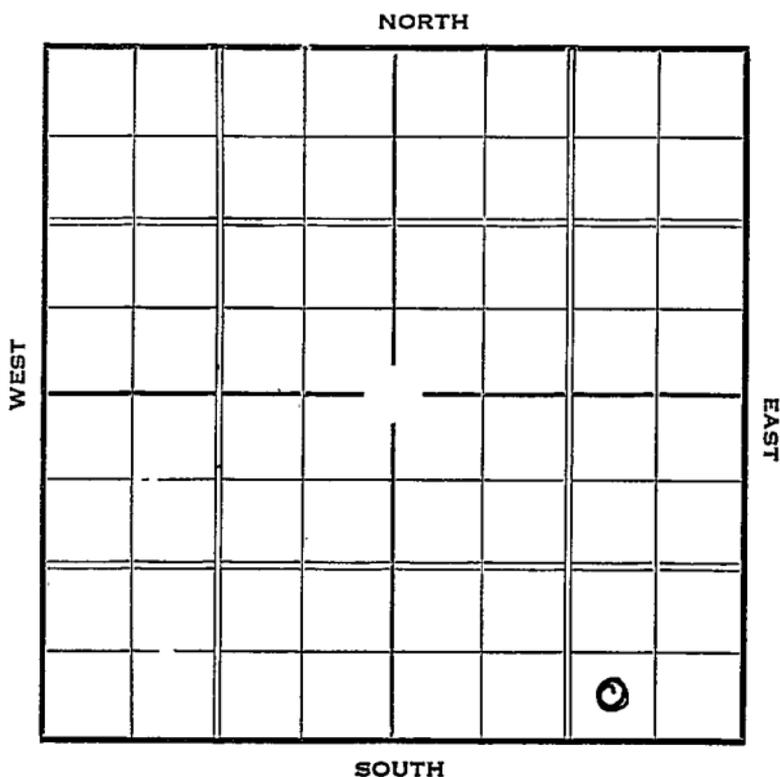

Sec. 21 Twp. 11 R. 17-W

Well No. #5 Bemis Farm
Empire Company


_____ Ft. from N. Line

330 Ft. from S. Line

990 Ft. from E. Line

_____ Ft. from W. Line

Elev. 1905

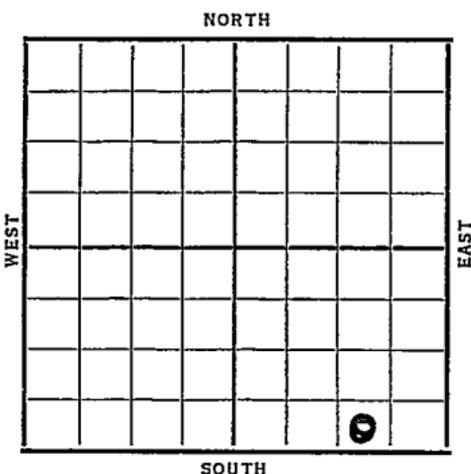

Date	REPORT
1937	
4/14	R O G
4/23	Rigging up
4/30	Spud 90'.
5/7	Anhy. 1120'. Rng. 10".
5/14	Drlg. 1925'.
5/21	Drlg. 2890'.
5/28	Sil. 3389-91'. Rng. Pipe.
6/4	7" @ 3391'. RUST.
6/11	Pay 3389-93'. Drlg. 3409'.
6/16	7" @ 3391'.
	Sil. 3389'.
	T.D. 3412'.
	Pot. 2021 bbls. 24 hrs.
	Natural. Down 2 hrs.
	COMPLETED

Map No. _____ Sec. 21 Twp. 11 R. 17W

Well No. 5 Bemis

Empire Company

Contractor

SECTION PLAT

			o

_____ Ft. from N. Line

330 Ft. from S. Line

990 Ft. from E. Line

_____ Ft. from W. Line

FIRST REPORT

Location _____

Rig up _____

Drilling and Remarks:

ROG

RECORD

Cased _____ in., _____ ft.

Sand _____

Gas _____

Oil _____

Total Depth _____

PRODUCTION

1st 24 hrs. Nat. _____

1st 24 hrs. after shot _____

Gas _____ Cu. Ft.

Dry Hole _____

Abandoned _____

Date

APR 14 1937 19

R. J. LEWIS Scout

Ellis KANSAS

Map No. 71 Sec. 21 Twp. 11 R. 17^W

Well No. 5-Bernis

Empire Company

Contractor

COMPLETED

SECTION PLAT

_____ Ft. from N. Line

330 Ft. from S. Line

990 Ft. from E. Line

_____ Ft. from W. Line

			o

Location _____

Rig up _____

Drilling and Remarks:

*Lot 2021/24
NATURAL
Down 2 hrs*

RECORD

Cased 7 in., 3391 ft.

Sand 511 3389

Gas _____

Oil _____

Total Depth 3412

PRODUCTION

1st 24 hrs. Nat. _____

1st 24 hrs. after shot _____

Gas _____ Cu. Ft.

Dry Hole _____

Abandoned _____

Date

JUN 15 1937 19

H. D. Hatfield

Scout