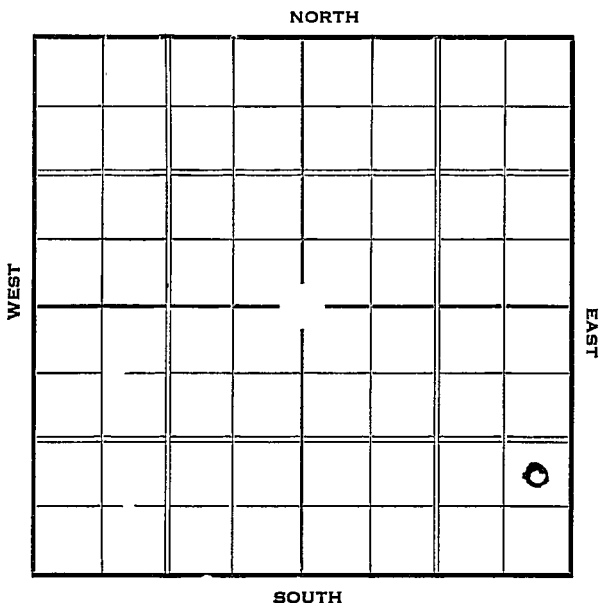


Ellis

KANSAS

Section 21 Township 11 Range 17-WWell Number 3 BemisCompany Empire

KANSAS

Ellis

Map No. _____ Sec. 21 Twp. 11 R. 17-W

Well No. #3 Bemis Farm.


Empire Company

Ft. from N. Line

990 Ft. from S. Line

330 Ft. from E. Line

Ft. from W. Line

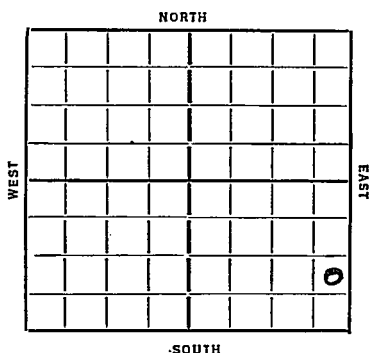

Date
1936

REPORT

12/16 Location
12/24 R O G
12/29 15" @ 110'. WOC.

1937

1/7	Anhydrate 1114'. set 10".
-----	---------------------------

Drlg. 1383'.

1/14 Drlg. 2425'.

1/21 Dr1g. 3315'.

1/28 Sil. 3399'. 7" @ 3402'. WOC.

2/4	TD 3427 Hole-full-oil
-----	-----------------------

2/10 Sil. 3399.

T. D. 3427'.

Potential 2117 natural

~~COMPLETED~~

Map No. 71 Sec. 21 Twp. 11 R. 17W.

Well No. 3 Bemis

Empire Company

Contractor

SECTION PLAT

 Ft. from N. Line

990 Ft. from S. Line

230 Ft. from E. Line

 Ft. from W. Line

FIRST REPORT

Location ✓

Rig up

Drilling and Remarks:

RECORD

Cased in., ft.

Sand

Gas

Oil

Total Depth

PRODUCTION

1st 24 hrs. Nat.

1st 24 hrs. after shot

Gas Cu. Ft.

Dry Hole

Abandoned

Date

DEC 10 1936 19

S. J. LEWIS Scout

KANSASMap No. _____ Sec. 21 Twp. 11 R. 12WWell No. 3 BemisEmpire Company_____
Contractor**SECTION PLAT**

			0

Ft. from N. Line990 Ft. from S. Line330 Ft. from E. Line_____
Ft. from W. Line**COMPLETED****RECORD**

Location _____

Cased _____ in., _____ ft.

Rig up _____

Sand _____

Drilling and Remarks:

Gas _____

Oil _____

Total Depth 3427**PRODUCTION**

1st 24 hrs. Nat. _____

1st 24 hrs. after shot _____

Gas _____ Cu. Ft.

Dry Hole _____

Abandoned _____

Date

FEB 10 1937

19

S. J. LEWIS Scout