


Section 21 Township 11 Range 17-W

Well No. #4 Bemis

Company Phillips

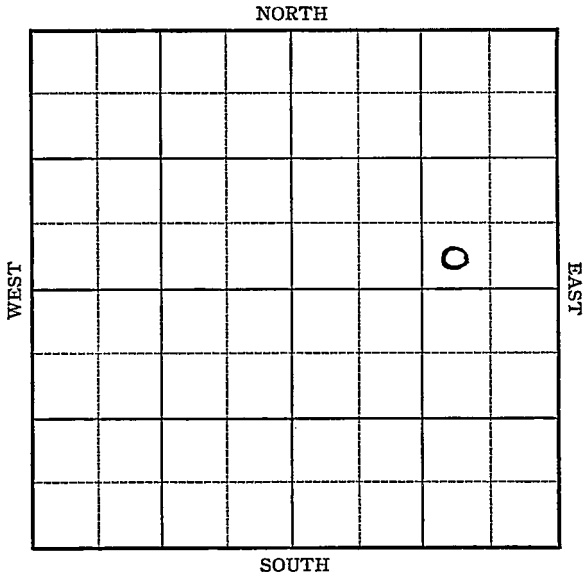

Sec. 21 Twp. 11 R. 17-W

Well No. #4 Bemis Farm

Phillips Company


         Ft. from N. Line

330 Ft. from S. Line

990 Ft. from E. Line

         Ft. from W. Line

Elev. 1844

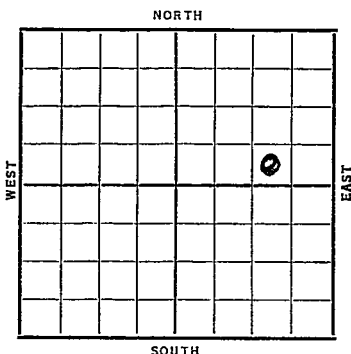

Date	REPORT
1937	
11/17	R U R
11/26	Anhy 1060'. 10" @ 1069'. WOC.
12/3	Drlg. 2719'.
12/10	Simp. 3335'. Sat. 3345-48'.
	Sil. 3350'. T.D. 3353'. no show. 7" @ 3345'. WOC.
12/17	" " " "
12/24	Cored 3353-60' T.D.
	Swab 384 bbls. oil 6 hrs.
12/31	T.D. 3360'.
1938	
1/7	" " " "
1/12	7" @ 3345'.
	Arb. 3350'.
	T.D. 3360'.
	Potential 3097 bbls, Nat.
	COMPLETED

Map No. 71 Sec. 21 Twp. 11 R. 17WWell No. 4 BemisPhillips

Company

Contractor

## FIRST REPORT

SW SE NE

       Ft. from N. Line330 Ft. from S. Line990 Ft. from E. Line       Ft. from W. Line

## SECTION PLAT

			0

Location       Rig up       

Drilling and Remarks:

RUR

## RECORD

Cased        in.,        ft.Sand       Gas       Oil       Total Depth       

## PRODUCTION

1st 24 hrs. Nat.       1st 24 hrs. after shot       Gas        Cu. Ft.Dry Hole       Abandoned       

Date

NOV 17 1937

19

H. D. Hatfield Scout

Ellis KANSAS

Map No. 71 Sec. 21 Twp. 11 R. 17WWell No. 4 BemisPhillips Petroleum Company

Contractor

**COMPLETED**

## SECTION PLAT

SW SE NE

       Ft. from N. Line330 Ft. from S. Line990 Ft. from E. Line       Ft. from W. Line

			0

Location       Rig up       

Drilling and Remarks:

POT-3097

NAT.

## RECORD

Cased 7 in., 3345 ft.~~Sand~~ Arb 3350Gas       Oil       Total Depth 3360

## PRODUCTION

1st 24 hrs. Nat.       1st 24 hrs. after shot       Gas        Cu. Ft.Dry Hole       Abandoned       

Date

JAN 12 1938 19

H. D. Hatfield Scout