


Section 21 Township 11 Range 17-W

Well Number #3 Bemis

Company Phillips

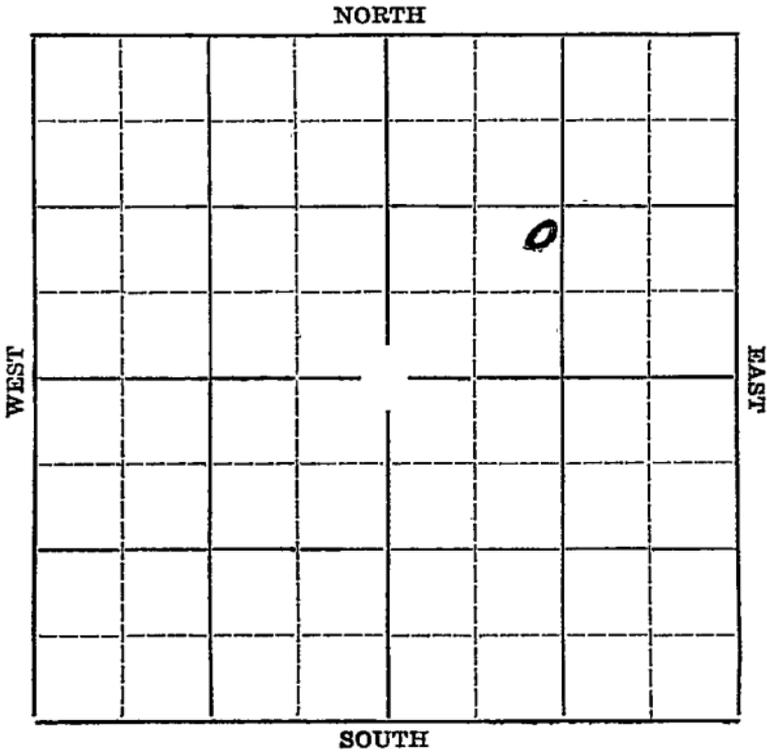

Sec. 21 Twp. 11 R. 17W

Well No. #3 Bemis Farm
Phillips Company


_____ Ft. from N. Line

990' Ft. from S. Line

_____ Ft. from E. Line

1270' ⁸ Ft. from W. Line

Elev. 1841

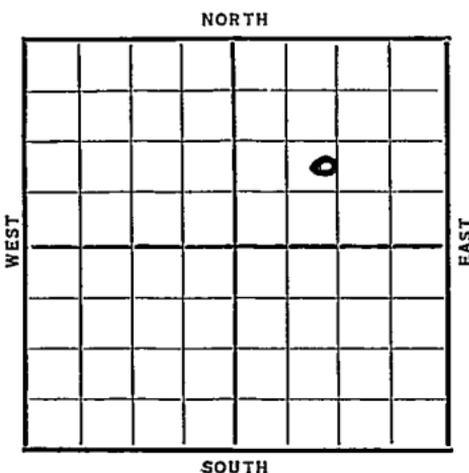

Date	REPORT
10/21	Rig.
10/29	Rigging up
11/6	Drlg. 830
11/12	Anhydrate 1056' 10" @ 1073 Drlg. 1740'.
11/19	Drlg. 3037'
11/27	Sil. 3354' ^{3363 (corrected)} Set 7".
	T. D. 3355'. Clean out.
12/3	Sil. 3363'. (Corrected)
	T. D. 3389'. Shut down.
12/10	7" @ 3364'. T. D. 3387½'. SLM Shot 20 qts. 3374-87½'.
	Swabbed 60 bbls. 20 hrs.
	Swabbed down.
12/17	Shut down.
12/22	Sil. 3363'. Shot 20 qts.
	1000 acid. T. D. 3389'.
	Pot. 356 oil. 14 water.
COMPLETED	

KANSAS

Map No. 71 Sec. 21 Twp. 11 R. 12W

Well No. 3 Benin

Phillips Company

Contractor

SECTION PLAT

		o	

_____ Ft. from N. Line

990 Ft. from S. Line

_____ Ft. from E. Line

1270 Ft. from W. Line

FIRST REPORT

Location _____

Rig up _____

Drilling and Remarks:

Rig

RECORD

Cased _____ in., _____ ft.

Sand _____

Gas _____

Oil _____

Total Depth _____

PRODUCTION

1st 24 hrs. Nat. _____

1st 24 hrs. after shot _____

Gas _____ Cu. Ft.

Dry Hole _____

Abandoned _____

Date _____

OCT 21 1936

S. J. LEWIS

Scout

Edwards **KANSAS**

Map No. 71 Sec. 21 Twp. 11 R. 17W

Well No. 3 Bemis

Phillips Company

Contractor

SECTION PLAT

_____ Ft. from N. Line

990 Ft. from S. Line

_____ Ft. from E. Line

1270 Ft. from W. Line

COMPLETED

Location _____

Rig up _____

Drilling and Remarks:

*Oil 8363
Shot 209 to
1000 acid
P. Y. 356 oil
14 water.*

RECORD

Cased _____ in., _____ ft.

Sand _____

Gas _____

Oil _____

Total Depth 3389

PRODUCTION

1st 24 hrs. Nat. _____

1st 24 hrs. after shot _____

Gas _____ Cu. Ft.

Dry Hole _____

Abandoned _____

Date

DEC 22 1936 19

S. J. LEWIS Scout