


Ellis

Section 21 Township 11 Range 17-W

Well No. 6 - Bemis

Company Uscan Oil

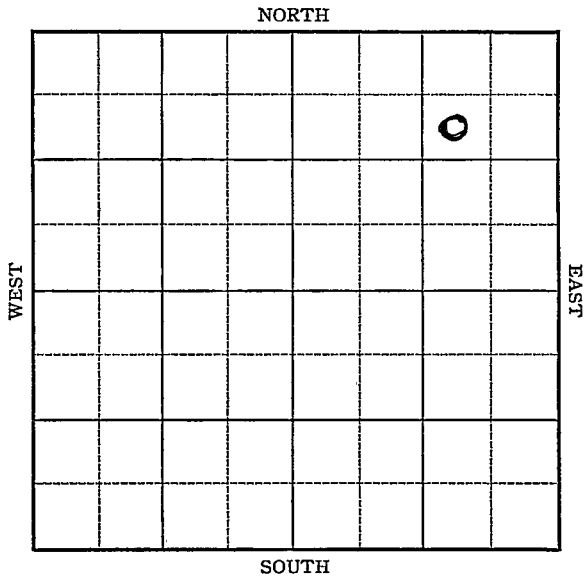

1937

9/29 7" @ 3364'.
Sil. 3362'.
T.D. 3385' S.W.
P.B. 3381'.
2000 acid.
Pot. 15 bbls.
Minimum Well.

COMPLETED

Ellis KANSAS

Map No. _____ Sec. 21 Twp. 11 R. 17WWell No. 6- BemisUscon Oil Company**FIRST REPORT** Contractorsw ne ne**SECTION PLAT**

			<u>6</u>

990 Ft. from N. Line

_____ Ft. from S. Line

990 Ft. from E. Line

_____ Ft. from W. Line

Location _____

Rig up _____

Drilling and Remarks:

15" - 52Any - 104010" - 1040Dry - 2180**RECORD**

Cased _____ in., _____ ft.

Sand _____

Gas _____

Oil _____

Total Depth _____

PRODUCTION

'1st 24 hrs. Nat. _____

'1st 24 hrs. after shot _____

Gas _____ Cu. Ft.

Dry Hole _____

Abandoned _____

Date

AUG 25 1937 19H. D. Hatfield

Scout

Map No. _____ Sec. 21 Twp. 11 R. 17WWell No. 6- Bemis_____ Uscan Oil _____ Company

_____ Contractor

COMPLETED**SECTION PLAT**

SW NE NE

990 Ft. from N. Line .

_____ Ft. from S. Line

990 Ft. from E. Line

_____ Ft. from W. Line

			0

Location _____

Rig up _____

Drilling and Remarks:

P.B. 3381
2000 acid
pot 15
minimum well

RECORDCased 7 in., 3364 ft.~~Sand~~ 511 3362

Gas _____

Oil _____

Total Depth 3385**PRODUCTION**

1st 24 hrs. Nat. _____

1st 24 hrs. after shot _____

Gas _____ Cu. Ft.

Dry Hole _____

Abandoned _____

Date

SEP 29 1937 19

H. D. Hatfield

Scout