


Section 21 Township 11 Range 17-W

Well Number #5-Bemis

Company Uscan Oil

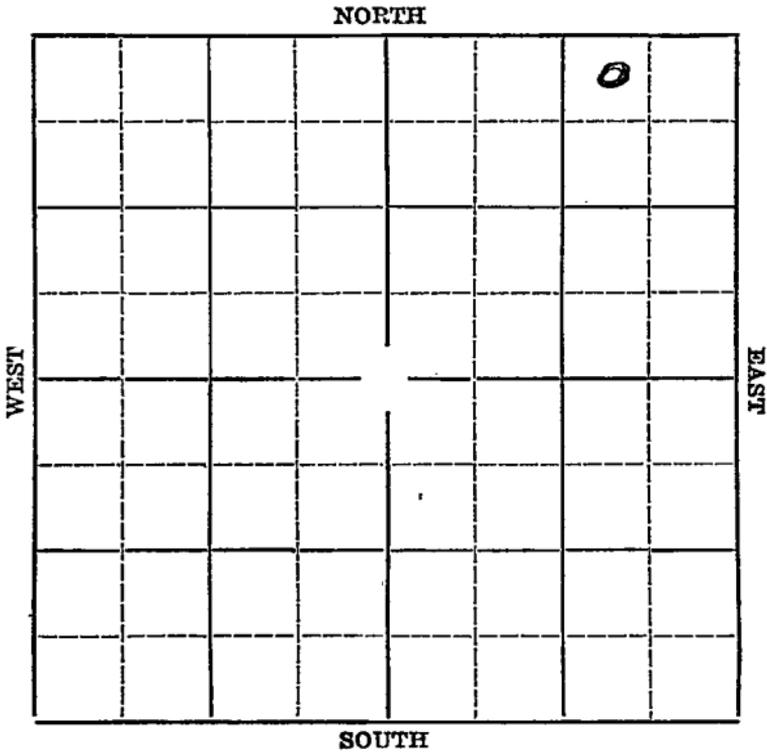

Map No. 71 Sec. 21 Twp. 11 R. 17W

Well No. 5 Bemis

Uscan Oil Company

Contractor

SECTION PLAT

			0

820 Ft. from N. Line

_____ Ft. from S. Line

990 Ft. from E. Line

_____ Ft. from W. Line

FIRST REPORT

Location _____

Rig up _____

Drilling and Remarks:

RCG

RECORD

Cased _____ in., _____ ft.

Sand _____

Gas _____

Oil _____

Total Depth _____

PRODUCTION

1st 24 hrs. Nat. _____

1st 24 hrs. after shot _____

Gas _____ Cu. Ft.

Dry Hole _____

Abandoned _____

Date

AUG 19 1936 19

S. J. LEWIS

Scout

Map No. 71 Sec. 21 Twp. 11 R. 12W

Well No. 5 Bemis

Uscan Oil Company

Contractor

SECTION PLAT

			0

330 Ft. from N. Line

_____ Ft. from S. Line

990 Ft. from E. Line

_____ Ft. from W. Line

COMPLETED

Location _____

Rig up _____

Drilling and Remarks:

Sil 2339

Pa 81307

RECORD

Cased _____ in., _____ ft.

Sand _____

Gas _____

Oil _____

Total Depth 2342

PRODUCTION

1st 24 hrs. Nat. _____

1st 24 hrs. after shot _____

Gas _____ Cu. Ft.

Dry Hole _____

Abandoned _____

Date

Oct 7 1936

S. J. LEWIS Scout