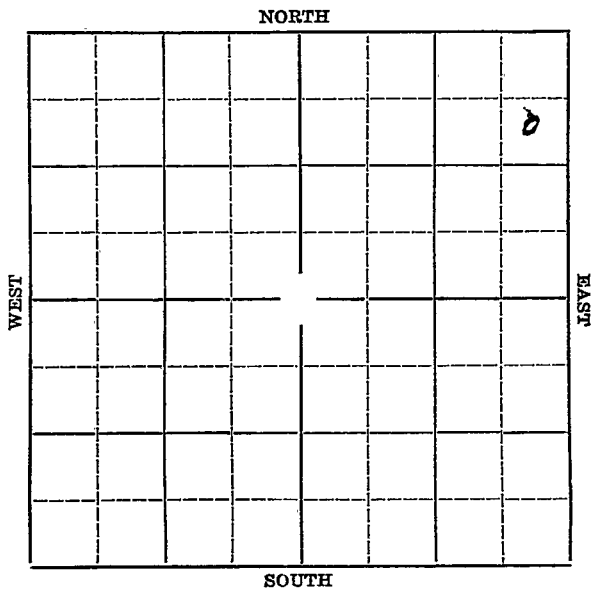


Section 21 Township 11 Range 17-WWell Number 3-BemisCompany Uscan

Map No. KANSAS Sec. 21 Twp. 11 R. 17WWell No. #3 Bemis FarmUscan

Company

NORTH

990' Ft. from N. Line

Ft. from S. Line

330' Ft. from E. Line

Ft. from W. Line

WEST

EAST

Elev. 1858

SOUTH

Date	REPORT
1936	
6/10	Rig on ground.
6/18	-- 6/25--7/2--7/9--
7/16	Rig.
7/23	Rigging up.
7/30	Drlg. 335'.
8/6	Drlg. 770'-15" @ 564'.
8/13	Drlg. 1100' 1110'.
8/20	Drlg. 1930'.
8/27	10" @ 2230'. Drlg. 2245'.
9/3	Drlg. 2575'.
9/10	8" @ 2570'. Drlg. 2745'.
9/18	Drlg. 2885'.
9/24	Drlg. 3200'.
10/1	Siliceous 3374'. 7" @ 3374'. WOC.
10/7	36-Sil. 3374'.
	T.D. 3383'.
	2260 bbls of oil potential. Nat.
	COMPLETED

Map No. 71 Sec. 21 Twp. 11 R. 19WWell No. 3 BernieMoan Company

Contractor

SECTION PLAT

			o

990 Ft. from N. Line

_____ Ft. from S. Line

330 Ft. from E. Line

_____ Ft. from W. Line

FIRST REPORT

Location _____

Rig up _____

Drilling and Remarks:

ROG.

RECORD

Cased _____ in., _____ ft.

Sand _____

Gas _____

Oil _____

Total Depth _____

PRODUCTION

1st 24 hrs. Nat. _____

1st 24 hrs. after shot _____

Gas _____ Cu. Ft.

Dry Hole _____

Abandoned _____

Date

JUN 10 1936

19

Scout

Map No. 71 Sec. 21 Twp. 11 R. 12WWell No. 3 BenoisUscon Oil Company

Contractor

SECTION PLAT

			0

990 Ft. from N. Line

_____ Ft. from S. Line

330 Ft. from E. Line

_____ Ft. from W. Line

COMPLETED

Location _____

Rig up _____

Drilling and Remarks:

Oct 33742260 NaX

RECORD

Cased _____ in., _____ ft.

Sand _____

Gas _____

Oil _____

Total Depth 3383

PRODUCTION

1st 24 hrs. Nat. _____

1st 24 hrs. after shot _____

Gas _____ Cu. Ft.

Dry Hole _____

Abandoned _____

Date

OCT 7 1936S. J. LEWIS Scout