

KANSAS


Form 51-5M-4-36-Palace

Ellis

Section 21 Township 11 Range 17W

Well Number #2 Bemis

Company Uscan Oil

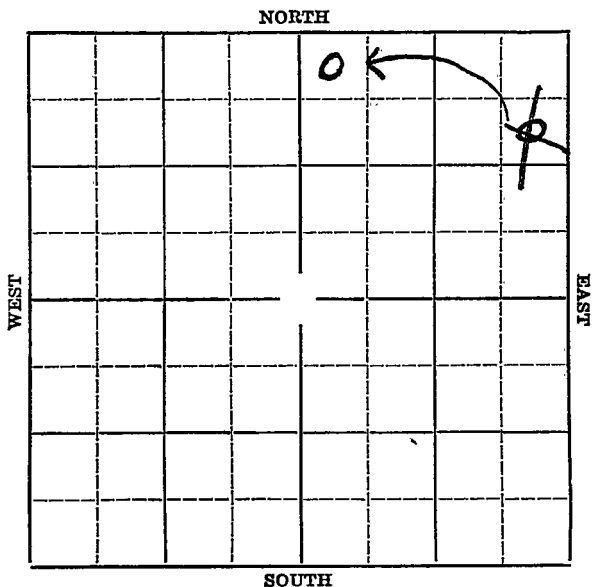


Map No. KANSAS Sec. 21 Twp. 11 R. 17WWell No. #2 Bemis FarmUsean Oil.

Company

330
~~990~~ Ft. from N. Line

Ft. from S. Line

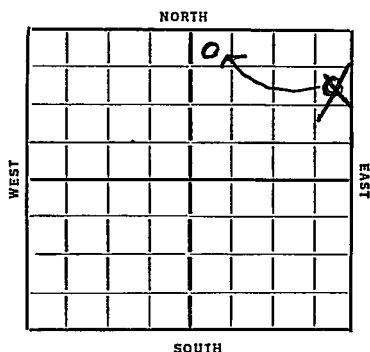~~330~~ Ft. from E. Line330 Ft. from W. LineDate
1936

REPORT

5/20 Ponds.

5/28 -- ~~6/4~~ --

6/4 Rig.

6/11 100'. Waiting on cement.

6/18 Drlg. 780'.

6/25 Drlg 1315'.

7/2 Drlg. 1985'.

7/9 Drlg. 2375'.

7/16 8" @ 2570'. Drlg. 2725'.

7/23 Topeka 2760'. Drlg. 2969'.

7/30 8" @ 3065'. Drlg. 3150'.

8/6 Siliceous 3347'. 6" @ 3348'. Pay
3369'. -75'. TD 1700' oil in 10 hrs.

8/13 Potential 545 bbls of oil.

8/20 Shut down.

8/27 -- 8/3 --

9/9/36 Sil. 3347'.
T.D. 3375'.
2000 gallons acid.
Potential 1193 bbls 3% being wat.

COMPLETED

Map No. 71 Sec. 21 Twp. 11 R. 12WWell No. 2 BemisMscan Oil Company

Contractor

SECTION PLAT

			o

990 Ft. from N. Line

_____ Ft. from S. Line

330 Ft. from E. Line

_____ Ft. from W. Line

FIRST REPORT

Location _____

Rig up _____

Drilling and Remarks:

Pond.

RECORD

Cased _____ in., _____ ft.

Sand _____

Gas _____

Oil _____

Total Depth _____

PRODUCTION

1st 24 hrs. Nat. _____

1st 24 hrs. after shot _____

Gas _____ Cu. Ft.

Dry Hole _____

Abandoned _____

Date

MAY 20 1936 19

S. J. LEWIS

Scout

KANSAS

Map No. 71 Sec. 21 Twp. 11 R. 12WWell No. 2 BemisWheeler Oil Company

Contractor

SECTION PLAT

		0	

330 Ft. from N. Line

_____ Ft. from S. Line

_____ Ft. from E. Line

330 Ft. from W. Line

CORRECTION

Location _____

Rig up _____

Drilling and Remarks:

Reported
SENECA.

RECORD

Cased _____ in., _____ ft.

Sand _____

Gas _____

Oil _____

Total Depth _____

PRODUCTION

1st 24 hrs. Nat. _____

1st 24 hrs. after shot _____

Gas _____ Cu. Ft.

Dry Hole _____

Abandoned _____

Date

JUN 10 1936

19

S. J. LEWIS

Scout

KANSAS

Map No. 71 Sec. 21 Twp. 11 R. 17W

Well No. 2 Bemis

Okean Oil Company

Contractor

SECTION PLAT

		0	

330 Ft. from N. Line

_____ Ft. from S. Line

330 Ft. from E. Line

_____ Ft. from W. Line

COMPLETED

Location _____

Rig up _____

Drilling and Remarks:

Oil 3347

2000 acid

P 8/1/93

3% Water

RECORD

Cased _____ in., _____ ft.

Sand _____

Gas _____

Oil _____

Total Depth 3375

PRODUCTION

1st 24 hrs. Nat. _____

1st 24 hrs. after shot _____

Gas _____ Cu. Ft.

Dry Hole _____

Abandoned _____

Date

SEP 9 1936 19

S. J. LEWIS Scout