


Section 21 Township 11 Range 18W

Well No. 1 Wasinger "B"

Company SHELL  
Cities Service

Burnett Pool  
NORTH

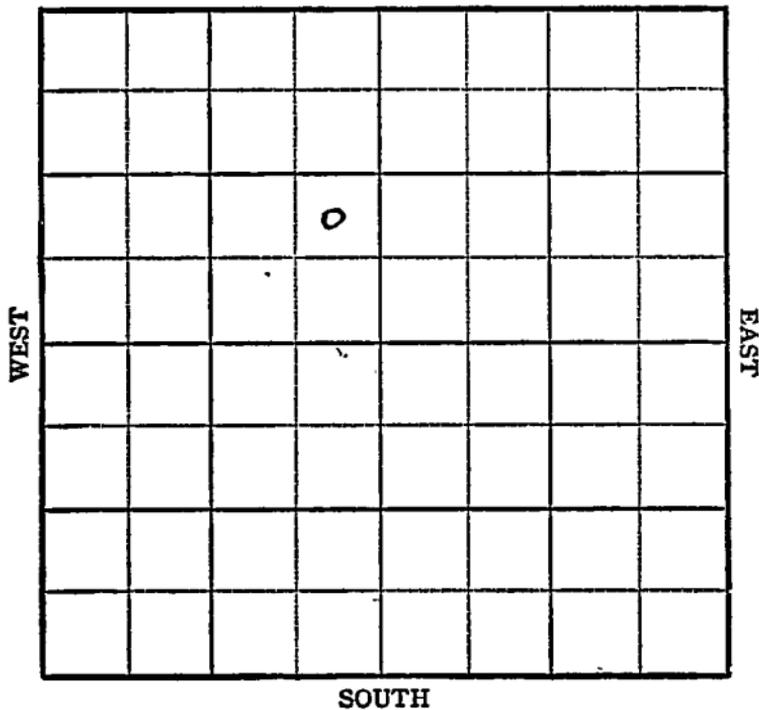

6

**O.W.W.O. KANSAS Ellis**

Sec. 21 Twp. 11 R. 18-W ✓✓

Well No. #1 Wasinger "B" Farm

~~Shell~~  
Cities Service Company


Burnett Pool

\_\_\_\_\_ Ft. from N. Line

965 Ft. from S. Line

330 Ft. from E. Line

\_\_\_\_\_ Ft. from W. Line

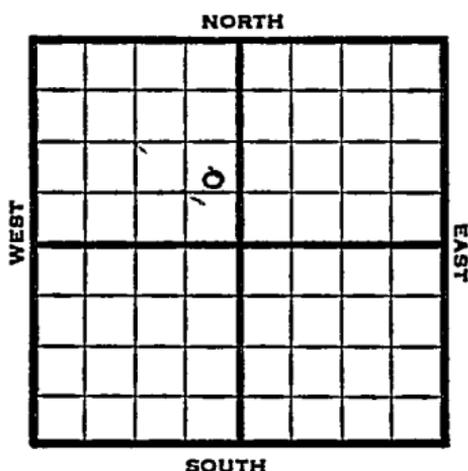

NE SE NW

1948 Elev 1942' REPORT

12/22 RUR  
12/29 8" @ 1226  
Drlg 1980'

1949  
1/12 TD 3540'  
Arb. 3504'  
Aband.

**ABANDONED.**

1952 **O.W.W.O.**

2/27 Lans. 3164 Arb. 3504  
D&A K & E MI to clean out  
& drill deeper for SWD

3/5 TD 3893' 5" @ 3550' WOC

3/12 Fishing at 3893'

3/19 CO to 3817

4/2 SWD Well TD 3893

Lans. 3164 Arb. 3504

CO to 3408 DD 3893

5" @ 3550 CO to 3817 10,000 A

Comp. for SWD well

**ABANDONED**

Map No. \_\_\_\_\_ Sec. 21 Twp. 11 R. 18W

Well No. 1 Wasinger "B"

Cities Service Company

**FIRST REPORT**

Contractor

NE SE NW


**SECTION FLAT**

\_\_\_\_\_ Ft. from N. Line

965 Ft. from S. Line

330 Ft. from E. Line

\_\_\_\_\_ Ft. from W. Line

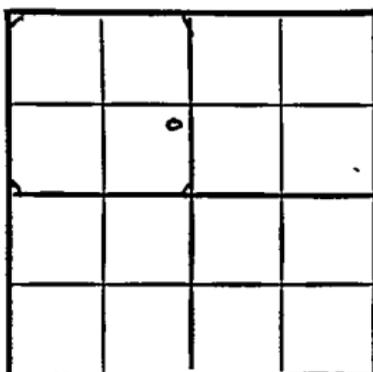

Ellis County

**RECORD**

Location \_\_\_\_\_

Cased \_\_\_\_\_ in., \_\_\_\_\_ ft.

Rig up \_\_\_\_\_

Sand \_\_\_\_\_

Drilling and Remarks:

Gas \_\_\_\_\_

Oil \_\_\_\_\_

Total Depth \_\_\_\_\_

R U R

**PRODUCTION**

1st 24 hrs. Nat. \_\_\_\_\_

1st 24 hrs. after shot \_\_\_\_\_

Gas \_\_\_\_\_ Cu. Ft.

Dry Hole \_\_\_\_\_

Abandoned \_\_\_\_\_

Date

DEC 22 1948

19

S. J. LEWIS

Scout

Kansas

Map No. 71 Sec. 21 Twp. 11 R. 18W

Well No. 1 Wasinger "B"

Cities Service Company

**ABANDONED**

Contractor

NE SE NW

*E 11942*  
SECTION PLAT

         Ft. from N. Line

965 Ft. from S. Line

330 Ft. from E. Line

         Ft. from W. Line

	o		

Ellis County

Location                                 

Rig up                                 

Drilling and Remarks:

*Per 83504*

**RECORD**

Cased          in.,          ft.

Sand                                 

Gas                                 

Oil                                 

Total Depth 3040

**PRODUCTION**

1st 24 hrs. Nat.                                 

1st 24 hrs. after shot                                 

Gas                                  Cu. Ft.

Dry Hole                                 

Abandoned                                 

Date

JAN 12 1949 19

S. J. LEWIS Scout

County Ellis State Kansas

Sec. 21 (Blk. Twp.) 11 (Sur. Rgs.) 18W Map No.

Operator Shell (Community Unit) (was GSO dry hole)

Well No. 1 Farm Wasinger (B)

Elev. 1942 Location NE SE NW


990 Ft. From S Line NW

330 Ft. From E Line Quarter

1st. Report FEB 27 1952

Completion \_\_\_\_\_

Remarks O.W.W.O.

**O.W.W.O.**

Spudding Date \_\_\_\_\_

Drig. Data \_\_\_\_\_

Lans 3164 Arb 3504 D&A - K & E MI  
to clean out & drill deeper for SWD

**J. G. McGEHEE**

O.W.W.O.

County Ellis State Kansas

Sec. 21 (Blk. 11 (Twp.)) (Sur. 18W (Rge.)) Map No.

Operator Shell (Community Unit)

Well No. 1 Farm Wasinger "B"

Elev. 1942 Location NE SE NW

		0			
		ABANDONED			

990 Ft. From S Line NW

330 Ft. From E Line Quarter

Ist. Report

APR 2 1952

Completion

Remarks O.W.W.O.

Spudding Date

Drlg. Data SWD well TD 3893

Lans. 3164 Arb. 3504 CO to 3408

DD 3893 5" @ 3550 CO to 3817 10000 A

Comp. for SWD well