

LAUGHLIN-SIMMONS & CO. OF KANSAS, INC.

OIL FIELD SURVEYING

1337 NORTH MERIDIAN, SUITE 2

WICHITA, KANSAS 67203

(316) 943-5351

KW1210796

INVOICE NO.

12-15-79

DATE

Trego

COUNTY

33

S

11s

T

22w

R

NW SE NW

LOCATION

Rupe Oil Company

OPERATOR

2

NO.

Flagler

FARM

ELEVATION:

2375 Gr.

DEC 20 1979


Rupe Oil Company, Inc.  
P.O. Box 2275  
Wichita, Kansas 67201

AUTHORIZED BY:

Bill Clement

PHONE #

next trip

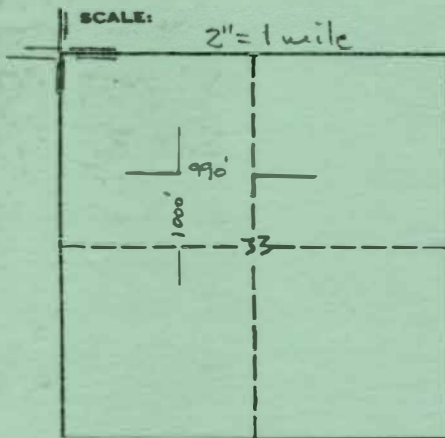

4' 3/4' STKS  
level w heat.

MINIMUM STAKING CHARGE:  
(INCLUDES GROUND ELEVATION)

\$95.00

EXTRA TIME & MILEAGE:

\$25.00

ELEVATION CHARGE:

TOTAL:

\$120.00

L. D. Zwicker

L-S SURVEYOR

Laughlin-Simmons & Co. of Kansas, Inc. is not liable in case of errors and/or omissions.

mailed copy John Cecil  
Monmouth 12/27/79