

Section 22 Township 11 Range 16WWell No. #1 GlickCompany Pabco Drlg.

NORTH

0							

WEST

EAST

SOUTH

Ellis

KANSAS

Sec. 22 Twp. 11 R. 16 W

Well No. # 1 Glick Farm

Pabco Drlg. Company

Contractor

Chrisler

Ft. from N. Line


330 Ft. from S. Line

Ft. from E. Line

330 Ft. from W. Line

SW SW NW

Great Lakes - F.O.

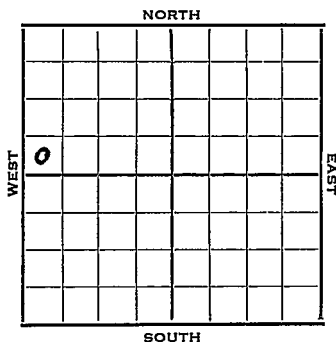

1952 Elv. 1850' REPORT

4/2 MIR
4/9 Anhy 1005'
8" @ 1015'
Drlg. 2699'

4/23 Lans. 3065'
DST 3114-29', 1 hr, 90' SOCM, 650#
RTD 3137' 5" @ 3137' DP 3113'
36/3093-3102' SSO 3000 A 12 gal
OPH for 12 hrs. 1000 A
Test 26 gal OPH PB 3050'
24/3038-42' Testing

4/30 1000 A S/8 BO 14 hrs Topeka 2782
Heeb. 3018 Tor. 3037 to PB


5/7 NR

5/14 NR

5/21 Spud 4-1-52
Oil Well TD 3137
Anhy 1005 8" @ 1015 Lans. 3065
DST 3114-29 open 1 hr. rec. 90' socm
TD 3137 5" @ 3137 DP 3113
36/ 3093-3102 SSO 3000 A 12 goph
1000 A 26 goph PB 3050 24/ 3038-42
1000 A S/ 8 bo 14 hr. Top. 2782
Heeb. 3018 Tor. 3037
Comp. 20 bopd

COMPLETED

County Ellis State Kansas
 (Blk.) (Sur.)
 Sec. 22 11 16W Map No.
 (Twp.) (Rge.)
 Operator Pabco Drlg.
 Well No. 1 Farm Glick
 Elev. 1850 Location SW SW NW

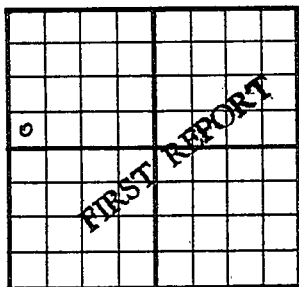

330 Ft. From S Line NW
330 Ft. From W Line Quarter
 Ist. Report APR 2 1952
 Completion _____
 Remarks Great Lakes - F.O.
 Spudding Date _____

Drlg. Data

ChrislerMIRJ. G. McGEHEE



Sec.	22	(Blk. Twp.)	11	(Sur. Rge.)	16W	Map No.
------	----	----------------	----	----------------	-----	---------

Well No. 1 Farm Glick

Elev.	1850	Location	SW SWNW
-------	------	----------	---------

330 Ft. From S Line NW

330 Ft. From W Line Quarter

1st. Report _____

1st. Report

Completion MAY 21 1952

Remarks	Chrisler Pool
---------	---------------

Spudding Date 4-1-52

Drig. Data Oil well TD 3137

Anhy 1005 8" @ 1015 Lans. 3065

DST 3114-29 open 1 hr. Rec. 90' socm

TD 3137 5" @ 3137 DP 3113

36/ 3093-3102 SSO 3000 A 12 goph

1000 A 26 goph PB 3050 24/ 3038-42

1000 A S/ 8 bo 14 hr. Top. 2782

Heeb. 3018 Tor. 3037 Comp. 20 bopd

J. G. McGEHEE