

KANAS

Ellis

Section 22 Township 11 Range 16WWell No. 1 ChrislerCompany Huber et alWildcat
NORTH

0							

WEST

EAST

SOUTH

KANSAS

Ellis

Sec. 22 Twp. 11 R. 16W

Well No. #1 Chrisler Farm

Huber et al

Company

Wildcat


330' Ft. from N. Line

Ft. from S. Line

Ft. from E. Line

330' Ft. from W. Line

NW SW

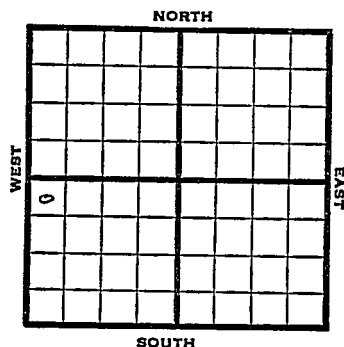

1949

Elev. 1848' REPORT

3/23	Location
3/30	RUR
4/6	8" @ 1001 Drlg 1700'
4/12	Lansing 3060' Drlg 3211'
4/20	Arb. 3425-60' TD 3460' 5" @ 3305'
4/27	36 shots 3100-12 2000 acid Swb 12 bbls oil PH 30% W 3 hrs
5/4	"
5/10	Pump 50 bbls oil / 70 W 24 hrs.
5/18	"
5/25	"
6/1	"
6/7	"
6/15	"
6/21	"
6/28	"
7/6	"
7/12	"
7/20	Arb. 3425' 5" @ 3305' Lans. 3060' Perf Lans. Pump 54 oil & 72% W Pot Grav. 29.0 TD 3460'

COMPLETED

Kansas

Map No. _____ Sec. 22 Twp. 11 R. 16WWell No. 1 Chrisler

Huber etal.

Company

FIRST REPORT

Contractor

NW SW

SECTION PLAT

o			.

330 Ft. from N. Line

_____ Ft. from S. Line

_____ Ft. from E. Line

330 Ft. from W. Line

Ellis County

Location X

Rig up _____

Drilling and Remarks:

RECORD

Cased _____ in., _____ ft.

Sand _____

Gas _____

Oil _____

Total Depth _____

PRODUCTION

1st 24 hrs. Nat. _____

1st 24 hrs. after shot _____

Gas _____ Cu. Ft.

Dry Hole _____

Abandoned _____

Date

MAR. 23 1949

19

S. J. LEWIS

Scout

Kansas

Chrisler Pool

Map No. K 71 Sec. 22 Twp. 11 R. 16WWell No. 1 Chrisler

Huber et al.

Company

COMPLETE

Contractor

NW SW

E. 1848

SECTION PLAT

330

Ft. from N. Line

Ft. from S. Line

Ft. from E. Line

330

Ft. from W. Line

0			

Ellis County

Location

Rig up

Drilling and Remarks:

Crt 83425

S. C 3305

L. ms 3060

Perf 4 am.

Pump 540 lb + 22 7/8

P. 4.

290/81

RECORD

Cased in ft.

Sand

Gas

Oil

Total Depth 3460

PRODUCTION

1st 24 hrs. Nat.

1st 24 hrs. after shot

Gas Cu. Ft.

Dry Hole

Abandoned

Date

JUL 20 1949

19

S. J. LEWIS

Scout