

Section 22 Township 11 Range 16W

Well No. #1 Chrisler

Company Graat Lakes Carbon

NORTH

WEST

LEAST

SOUTH

LANS

Ellis

Sec. 22 Twp. 11 R. 16-W

Well No. #1 Chrisler Farm

Great Lakes Carbon Company

Chrisler


990 Ft. from N. Line

 Ft. from S. Line

990 Ft. from E. Line

 Ft. from W. Line

SW NE SW

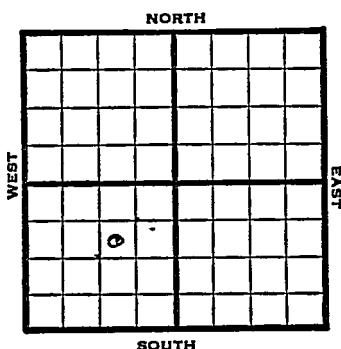

1950

Elev 1823' REPORT

2/22

RUR

3/8

TD 3105' in Lans.

8" @ 995'

Heeb 2995'

Lans 3043'

D&A

Aband.

ABANDONED

Map No. _____ Sec. 22 Twp. 11 R. 16WWell No. 1 Chrisler

Great Lakes Carbon _____ Company

Contractor _____

SW NE SW

990 Ft. from N. Line

_____ Ft. from S. Line

990 Ft. from E. Line

_____ Ft. from W. Line

SECTION PLAT

Ellis County

Location _____

Rig up _____

Drilling and Remarks:

R U R

RECORD

Cased _____ in., _____ ft.

Sand _____

Gas _____

Oil _____

Total Depth _____

PRODUCTION

1st 24 hrs. Nat. _____

1st 24 hrs. after shot _____

Gas _____ Cu. Ft.

Dry Hole _____

Abandoned _____

Date

FEB 22 1950 19J. E. TYRA Scout

Kansas


Chrisler Pool

Map No. _____ Sec. 22 Twp. 11 R. 16WWell No. 1 Chrisler

Great Lakes Carbon Company

Contractor

SW NE SW

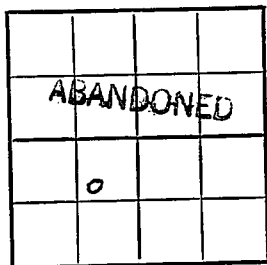F/ 1823
SECTION PLAT990 Ft. from N. Line

_____ Ft. from S. Line

990 Ft. from E. Line

_____ Ft. from W. Line

Ellis County

Location _____

Rig up _____

Drilling and Remarks:

8" @ 995

Hub 2995

Lans 3043

DVA.

RECORD

Cased _____ in., _____ ft.

Sand _____

Gas _____

Oil _____

Total Depth 3105 in. Lins

PRODUCTION

1st 24 hrs. Nat. _____

1st 24 hrs. after shot _____

Gas _____ Cu. Ft.

Dry Hole _____

Abandoned _____

Date

MAR 8 1950

J. E. TYRA

19

Scout