

Section 22 Township 11 Range 18W

Well No. #3 Henderson "F"

Company Mazda Oil

NORTH

0							

13

WEST

EAST

SOUTH

Ellis

Sec. 22 Twp. 11 R. 18W

Well No #3 Henderson "F" Farm

Mazda Oil Company

Harbar Drlg. - Contr. Contractor

Burnett Pool


Ft. from N. Line

230' Ft. from S. Line

Ft. from E. Line

410' Ft. from W. Line

SW SW SW Twin #2

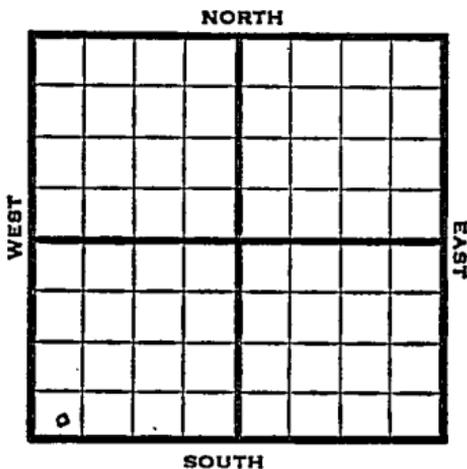

1950

Elev. 1968' REPORT

10/25

Spud 10-19-50
8" @ 1246'
Anhy 1234'
Drlg. 2010'

11/15

Spud 10-19-50
SWD Well TD 3672
8" @ 1246' Anhy 1234
KC 3185' Cong. 3439'
Simp. 3454' Arb. 3493'
5" @ 3580' TD 3672
Aband. for SWD Well

ABANDONED

