



Sec. 22 Twp. 11 R. 19 W

Well No. # 4 Allen Farm

Skelly Company


Soloman Contractor

990 Ft. from N. Line

\_\_\_\_\_ Ft. from S. Line

\_\_\_\_\_ Ft. from E. Line

990 Ft. from W. Line

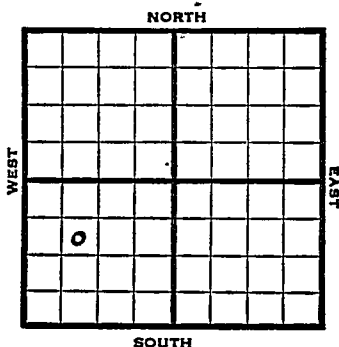

SE NW SW

1952

Elev. 2016' REPORT

- 1/30 Location
- 2/6 "
- 2/13 10" @ 306' WOC
- 2/20 Drlg. 2810'
- 3/5 Topeka 3000'  
Heeb 3200'  
Lans. 3240'  
Cong. 3487'  
Arb. 3543-46' RTD  
7" @ 3544' WOC
- 3/12 DP DD to 3554' TD 500 A Testing
- 3/19 P/1/2 BO & 1/4 BW 7 hrs. 1000A  
P/2 1/2 BO & 1/4 BW 10 hrs.  
Testing
- 3/25 Set Pkr. 3516 500 A
- 4/1 No test after A DD to 3562 TD  
750 A P 1 BO & 24 BW 6 hrs. PB  
3027 35/ 2998-3004 500 A  
S/ 1/2 BO & 2/3 BOPH for 4 hrs.  
sq. off
- 4/9 DP to 3012 12/ 2998-3002 test  
SSO & 15 gal wph 16/ 2998-3002  
SSO & wtr. 500 A S/ 1/3 BO & 4 1/2  
BWPB set plug 2995 36/ 2990-94  
S/ 3 BO & 36. BW 12 hrs. 1250A no help  
drove plug to 3010 P/ 10 BO & 94 bw  
20 hrs.

OVER

1952

4/23 NR

4/30 "

5/7 "

5/14 "

5/21 Spud 2-8-52

Oil Well TD 3562' 10" @ 306

Top. 3000 Heeb. 3200

Lans. 3240 Cong. 3487

Arb. 3543-46

7" @ 3544 TD 3554 500 A & P/ 1 $\frac{1}{2}$  bo

$\frac{1}{4}$  bw 7 hr. 1000 A P/ 2 $\frac{1}{4}$  bo  $\frac{1}{4}$  bw

10 hr. SP 3516 500 A DD 3562

750 A P/ 1 bo 24 bw 6 hr.

PB 3027 35/ 2998-3004 500 A S/ 1/3

bo, 2/3 bwph DP 3012 12/ 2998-3002

SSO 15 gwph 16/ 2998-3002 SSO &

wtr. 500 A S/ 1/3 bo 4 $\frac{1}{2}$  bwph

SP 2995 36/ 2990-94 S/ 3 bo

36 bw 12 hr. 1250 A DP to 3020

P/ 10 bo 94 bw 20 hr.

Comp. 26 bopd 147 bw

**COMPLETED**



