


Section 22 Township 11 Range 19W

Well No. 3 Vine "D"

Company Skelly Oil

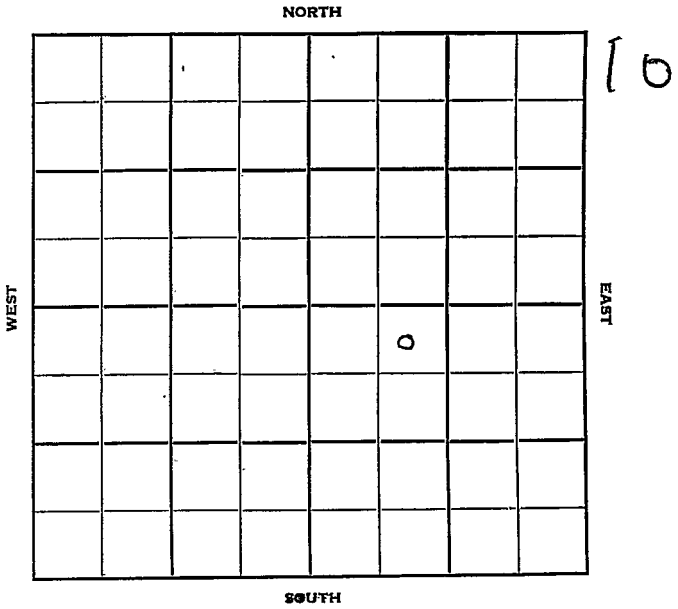

Sec. 22 Twp. 11 R. 19 W

Well No. # 3 Vine "D" Farm

Skelly Oil Company

Contractor

Soloman Pool


330 Ft. from N. Line

Ft. from S. Line

Ft. from E. Line

990 Ft. from W. Line

NE NW SE

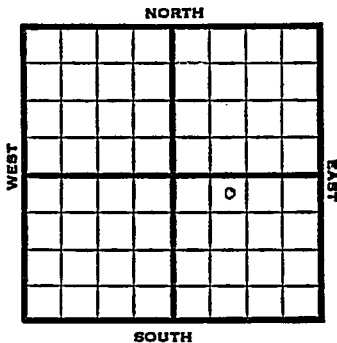

1951

Elev. 1971' REPORT

7/25

Location

8/29

Spud 7-28-51
 Oil Well TD 3503
 Anhy 1242
 8" @ 1252
 KC 3194 Cong. 3437
 Simp 3466 Arb. 3488-90
 5" @ 3489
 TD 3503
 1000 A S/61 BO 4 bw
 Comp. 164 bopd 2% wtr.

COMPLETED

County Ellis State Kansas

Sec. 22 (Blk. 11) (Sur. 19W) (Twp.) Map No.

Operator Skelly Oil

Well No. 3 Farm Vine "D"

Elev. 1971 Location NE NW SE

COMPLETE

330 Ft. From N Line SE

990 Ft. From W Line Quarter

Ist. Report

Completion AUG 29 1951

Remarks Soloman Pool

Spudding Date 7-28-51

Drlg. Data Oil well TD 3503

Anhy 1242 8" @ 1252 KC 3194 Cong. 3437

Simp. 3466 Arb. 3488-90 5" @ 3489

TD 3503 1000 A S/ 61 bo 4 bw

Comp. 164 bopd 2% water