


Section 22 Township 11 Range 19W

Well No. #1 Vine "E"

Company Skelly

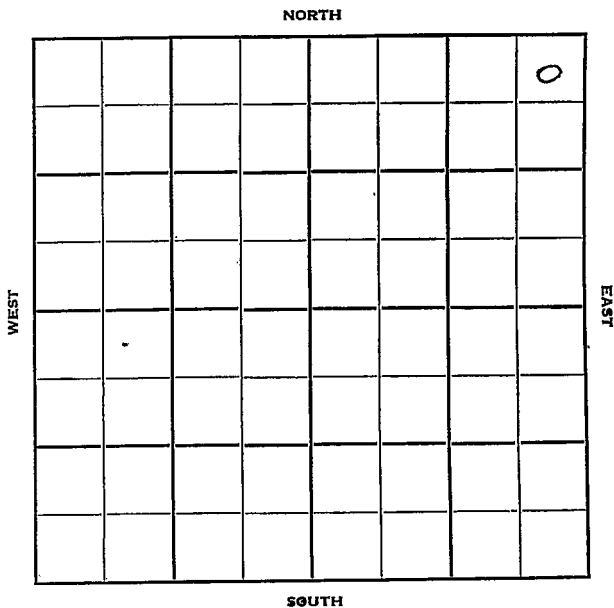

Sec. 22 Twp. 11 R. 19 W

Well No. # 1 Vine "E" Farm

Skelly Company

Contractor


330 Ft. from N. Line

Ft. from S. Line

330 Ft. from E. Line

Ft. from W. Line

NE NE NE

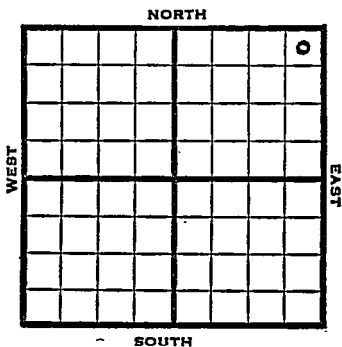

1951

*Elev 1939'* REPORT

3/14

Location

4/25

Spud 3-15-51

Oil well TD 3470'

13" @ 113 8" @ 1236

Top. 2916', Stain 2916-22' Heeb 3109

Lans. 3152' Cong 3397' Simp 3430'

Arb. 3451'

TD 3455' 5" @ 3452' CO to 3455'

FU 110' oil  $\frac{1}{2}$  hr. FU 1000' oil 5 hr.

DD 3458' FU 1300' oil 7 hr.

DD 3460' FU 1500' oil 9 hr.

DD 3463' FU 1800' oil 12 hr.

2000' oil 17 hr. 500 A S/80 BO

6 hr. P/117 BO 8 hr. DD 3466'

FU 2500' oil DD 3470' FU 2500'

oil 1000 A S/80 BO 8 hr.

Comp. 501 BOPD

**COMPLETED**



