


Section 22 Township 11 Range 19 W

Well No. # 3 Vine (E)

Company Skelly Oil Co.

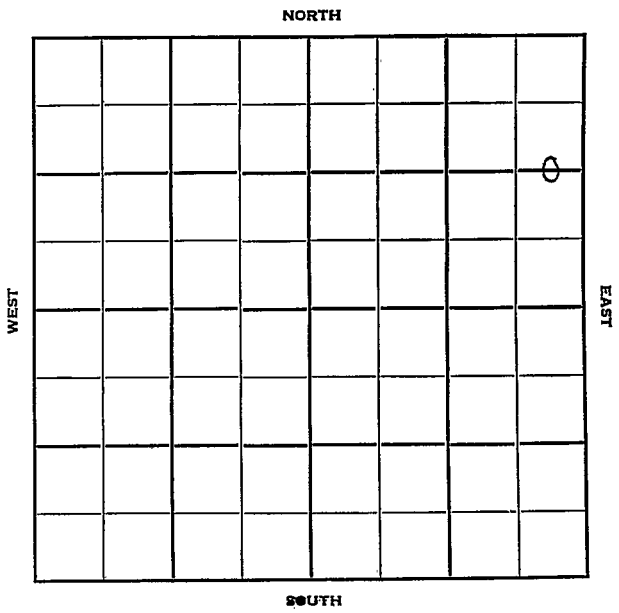

Sec. 22 Twp. 11 R. 19 W ✓

Well No. # 3 Vine (E) Farm _____

Skelly Oil Co. Company

Contractor _____

Soloman Pool


1320 Ft. from N. Line

_____ Ft. from S. Line

330 Ft. from E. Line

_____ Ft. from W. Line

C E/2 E/2 NE

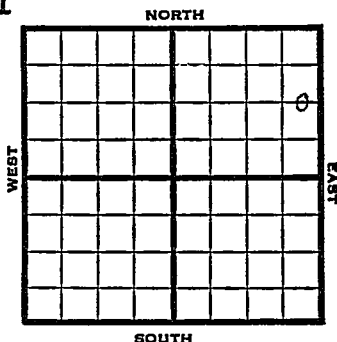

1951 Elev. 1937' REPORT

6/20 Spud 6-17-51
Drilling

7/11 Spud 6-17-51
D&A T D 3525
10" @ 1232
Heeb. 3116 Lans. 3158
Gong. 3396 Arb. 3475
DST 3475-80 opn 45 min
Rec. 20' mud & SSO
DST 3477-86 opn 1 hr Rec. 88' mud
TD 3525 D&A

ABANDONED

County Ellis State Kansas

Sec. 22 (Blk. Twp.) 11 (Sur. Rge.) 19 W Map No.

Operator Skelly Oil Co.

Well No. 3 Farm Vine (E)

Elev. _____ Location CE/2 E/2 NE

1320 Ft. From N Line NE
330 Ft. From E Line Quarter

Ist. Report JUN 20 1951

Completion _____

Remarks _____

FIRST REPORT

Spudding Date 6-17-51

Drlg. Data Soloman Pool

Drlg. _____

