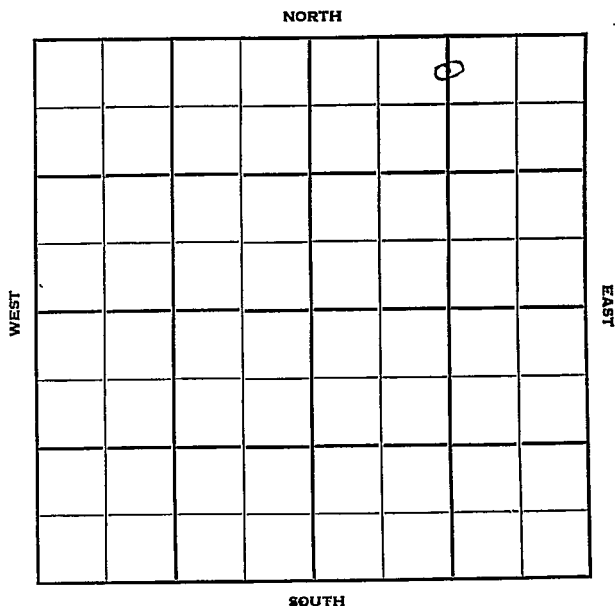


Section 22 Township 11 Range 19WWell No. #5 Vine (E)Company Skelly Oil

Ellis

Sec. 22 Twp. 11 R. 19W

Well No. #5 Vine (E) ✓ Farm

Skelly Oil

Company

Contractor

Solomon


330' Ft. from N. Line

_____ Ft. from S. Line

1320' Ft. from E. Line

_____ Ft. from W. Line

C N/2 N/2 NE

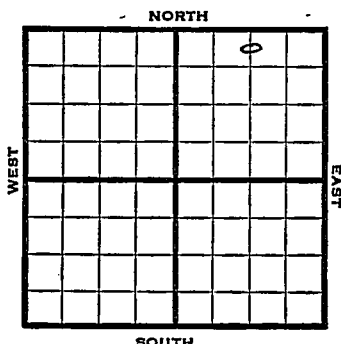

1952

Elev. 1942'

REPORT

1/23

Location

2/6

Drlg. 3160'
8" @ 300'

2/13

Topeka 2925 Heeb. 3117
Lans. 3157 Cong. 3397
Simp. 3436 Arb. 3458-64 TD
5" @ 3460'

2/20

WOC


3/5

DP to 3464' 300 A P/13 B0 plus
1 1/2 BW. 8 hrs,
DD to 3470' TD 750 A
P/100 B0 plus 2 BW 24 hrs.
Testing

3/12

Spud 1-23-52
Oil Well TD 3470
8" @ 300
Top. 2925 Heeb. 3117
Lans. 3157 Cong. 3397
Simp. 3436 Arb. 3458-64
5" @ 3460 TD 3464 300 A
P. 13 bo 1/2 bw 8 hr. DD 3470
750 A P/100 bo 2 bwpd
Comp. 116 bopd 1% wtr.

COMPLETED

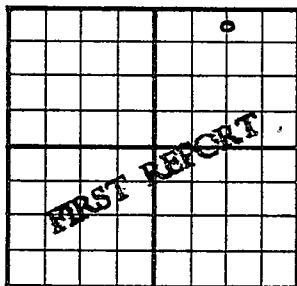County Ellis State KansasSec. 22 (Blk. Twp.) 11 (Sur. Rge.) 19W Map No.Operator Skelly OilWell No. 5 Farm Vine (E)Elev. Location C N/2 N/2 NE330 Ft. From N Line NE1320 Ft. From E Line Quarter1st. Report JAN 2-3 1952

Completion

Remarks

Spudding Date

Drlg. Data


SolomonLocationJ. E. TYRA

County Ellis State
 Sec. 22 (Blk.) 11 (Sur.) 19W Map No.
 (Twp.) (Rge.)

Operator Skelly Oil

Well No. 5 Farm Vine "E"

Elev. 1942 Location C N L N/2 NE

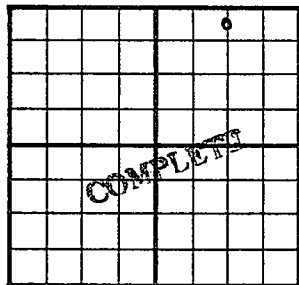

330 Ft. From N Line NE

1320 Ft. From E Line Quarter

Ist. Report

Completion MAR 12 1952

Remarks Solomon Pool

Spudding Date 1-23-52

Drlg. Data Oil well TD 3470

8" @ 300 Top. 2925 Heeb. 3117

Lans. 3157 Cong. 3397 Simp. 3436

Arb. 3458-64 5" @ 3460 TD 3464

300 A P/ 13 bo $\frac{1}{2}$ bw 8 hr. DD 3470

750 A P/ 100 bo 2 bwpd

Comp. 116 bopd 1% water