


Section 22 Township 11 Range 19 W

Well No. # 6 Allen

Company Skelly Oil

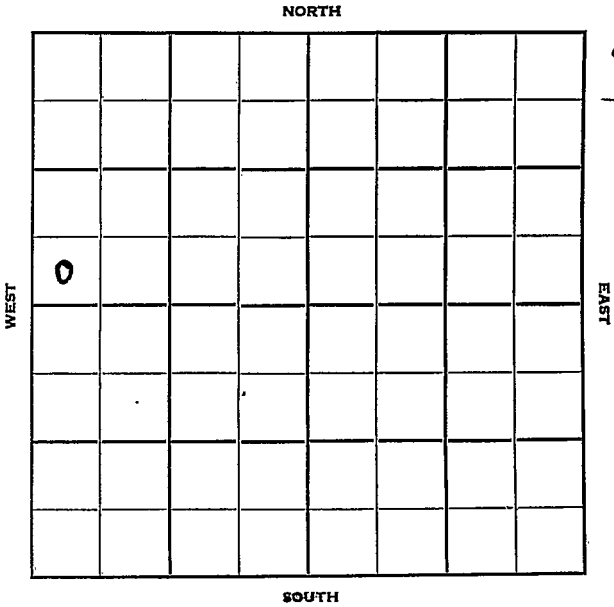

Sec. 22 Twp. 11 R. 19 W

Well No. # 6 Allen Farm

Skelly Oil Company

Contractor


Ft. from N. Line

330 Ft. from S. Line

Ft. from E. Line

330 Ft. from W. Line

SW SW NW

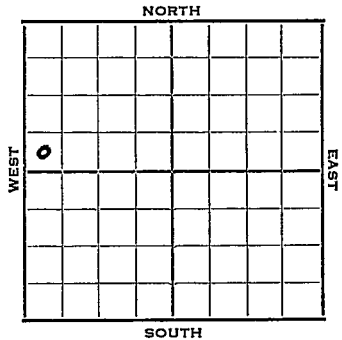

1952

Elev. 1969'

REPORT

6/11

Spud 6-2-52
8" @ 280
Drig. 2580'

6/18

Topeka 2945' Heeb 3140' Lans. 3180'
Gong. 3424' Simp shale 3459'
Arb. 3483'
RTD 3488' 5" @ 3484'

6/25

DP DD 3495' TD Fill up 2200' oil
16 hrs. S/54 BO 4 hrs. 500 A
P/128 BO 8 hrs.

7/2

Spud 6-2-52
Oil Well TD 3495 8" @ 280
Top. 2945 Heeb. 3140
Lans. 3180 Cong. 3424
Simp. 3459 Arb. 3483
TD 3488 5" @ 3484 TD 3495
FU 2200' oil 16 hr. S/ 54 bo
4 hr. 500 A P/ 128 bo 8 hr.
Comp. 1253 bopd

COMPLETED

