


Section 22 Township 11 Range 19 W

Well No. # 7 M. R. Allen

Company Skelly Oil

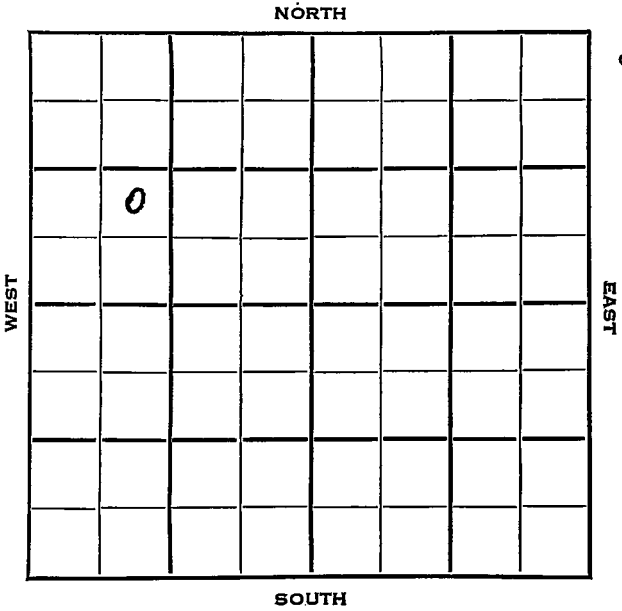

SEC.	TWP.	R.
22	11	19 W ✓
WELL NO.		
# 7 M. R. Allen		
COMPANY		FARM
Skelly Oil		
CONTRACTOR		

## Solomon Pool


\_\_\_\_\_ Ft. from N. Line

990 \_\_\_\_\_ Ft. from S. Line

\_\_\_\_\_ Ft. from E. Line

990 \_\_\_\_\_ Ft. from W. Line

NE SW NW

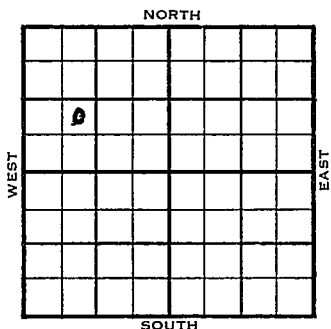

## ELEVATION

## REPORT

1953

7963'

9/30	Location
10/7	Anhy 1248' 8" @ 1258 Drlg. 1705'
10/14	Top 2941', Heeb 3138', Tor 3159', Lans 3180', Cong 3422', Simp 3463', Arb. 3484' RTD 3488' 5" @ 3485'
10/21	NR
10/28	DD 3494' TD 5GO & 1 GWPH 4 hrs.
11/4	NR
11/11	Spud 9-30-53 Oil Well TD 3498' Anhy 1248', 8" @ 1258' Top 2941', Heeb 3138', Tor 3159', Lans 3180', Cong 3422, Simp 3463, Arb 3 484, TD 3488' 5" @ 3485' DD 3494 50 go 1 gwph 4 hr. DD 3498

1953

Information brought forward.

11/11 300 A P/ 8 bo 16 hr. 750A  
P/ 11 bo 1 bw 4 hr. . .  
Comp 207 bopd 7 bw.

**COMPLETED**



