


Section 22 Township 11 Range 18W

Well No. #1 Henderson

Company J. Livingston

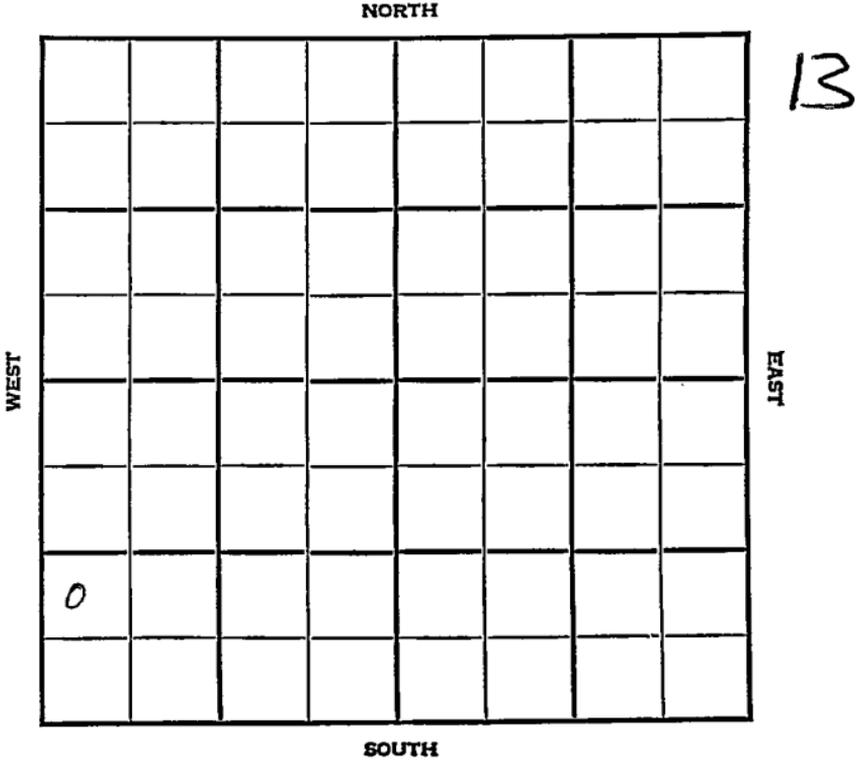

Sec. 22 Twp. 11 R. 18W

Well No. #1 Henderson Farm

J. Livingston Company


Burnett

 Ft. from N. Line

990 Ft. from S. Line

 Ft. from E. Line

330 Ft. from W. Line

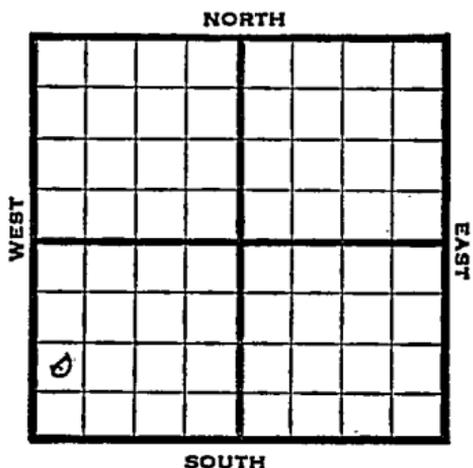

NW SW SW

1947 Elev. 1965' REPORT

11/19 Location
 11/25 "
 12/3 RUR
 12/10 8" @ 141'
 Drlg. 789'
 12/17 Drlg. 2827'
 12/30 Lansing 3193'
 Conglomerate 3446'
 Simpson 3485'
 Arbuckle 3496'
 TD 3500'
 5" @ 3496'
 RUST

1948
 1/7 Arb. 3496'
 5" @ 3496'
 Depth Pot. 3000
 Gr. 24°
 Total Depth 3507'

COMPLETED

Map No. _____ Sec. 22 Twp. 11 R. 18W

Well No. 1 Henderson

J. Livingston Company

FIRST REPORT Contractor

NW. SW SW

SECTION PLAT

_____ Ft. from N. Line

990 Ft. from S. Line

_____ Ft. from E. Line

330 Ft. from W. Line

0			

Ellis County

Location X

Rig up _____

Drilling and Remarks:

RECORD

Cased _____ in., _____ ft.

Sand _____

Gas _____

Oil _____

Total Depth _____

PRODUCTION

1st 24 hrs. Nat. _____

1st 24 hrs. after shot _____

Gas _____ Cu. Ft.

Dry Hole _____

Abandoned _____

Date

NOV 1 9 1947 19

S. J. LEWIS Scout

Map No. 71 Sec. 22 Twp. 11 R. 18W

Well No. 1 Henderson

J. Livingston Company

COMPLETE

Contractor

E. I. 1965

NW SW SW

SECTION PLAT

_____ Ft. from N. Line

990 Ft. from S. Line

_____ Ft. from E. Line

330 Ft. from W. Line

4			

Ellis County

Location _____

Rig up _____

Drilling and Remarks:

Oil 3496

5" 3496

Dep. No. 243000

2496

RECORD

Cased _____ in., _____ ft.

Sand _____

Gas _____

Oil _____

Total Depth 3496

PRODUCTION

1st 24 hrs. Nat. _____

1st 24 hrs. after shot _____

Gas _____ Cu. Ft.

Dry Hole _____

Abandoned _____

Date

JAN 7 1948 19

S. J. LEWIS

Scout