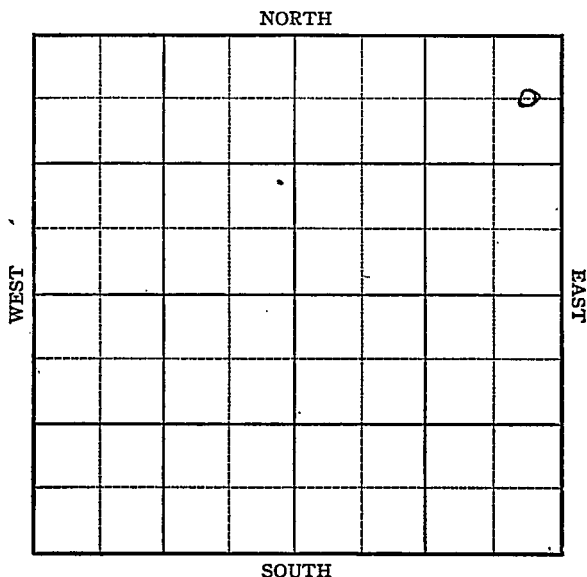


Section 22 Township 11 Range 18-WWell No. #1, Henderson "E"Company Lario Oil and Gas Company

KANSAS

Ellis

Sec. 22 Twp. 11 R. 18

Well No. #1 Henderson "E" Farm

Lario Oil & Gas Company

Burnett


660 Ft. from N. Line

Ft. from S. Line

330 Ft. from E. Line

Ft. from W. Line

C E L NE NE

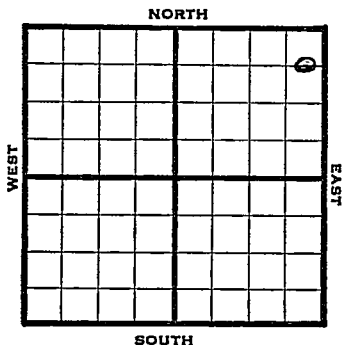

1946

Elev. 1971' REPORT

9/18	Location
9/24	"
10/1	"
10/8	"
10/15	RUR
10/22	8" @ 1256'
	Anhy 1251'
	Drlg 1466'
10/30	Drlg 2985'
11/5	Pang 3240-44
	Drlg 3254'
11/12	Topeka 2948'
	Lans 3196'
	Arb3516'
	TD 3573'
	5" @ 3573, RUST
11/20	30 shots 3521-27,250'
	Acid swb 6 oil PH 4 hrs
11/27	" " "
12/3	" " "
12/11	Arb 3516'
	5" @ 3573'
	TD 3573'
	Perf
	250 Acid
	Depth Pot 2911'
	20 Grav.

COMPLETED

KANSAS

Kansas

Pool Name BurnettMap No. 71 Sec. 22 Twp. 11 R. 18WWell No. 1 Henderson "E"Lario Oil & Gas


Company

FIRST REPORT

Contractor

C E L NE NE

SECTION PLAT

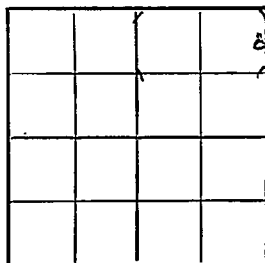660 Ft. from N. Line Ft. from S. Line330 Ft. from E. Line Ft. from W. LineEllis CountyLocation XRig up

Drilling and Remarks:

RECORD

Cased in., ft.Sand Gas Oil Total Depth

PRODUCTION

1st 24 hrs. Nat. 1st 24 hrs. after shot Gas Cu. Ft.Dry Hole Abandoned

Date

SEP 18 194619S. J. LEWIS


Scout

Kansas

Map No. 71 Sec. 22 Twp. 11 R. 18WWell No. 1 Henderson "E"Lario Oil and Gas Company**COMPLETE**

Contractor

C E L NE NE

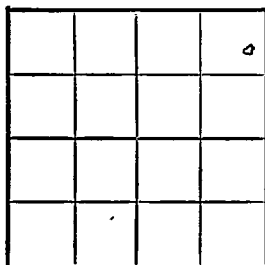E 11971
SECTION PLAT660 Ft. from N. Line Ft. from S. Line330 Ft. from E. Line Ft. from W. Line

Ellis County

Location Rig up

Drilling and Remarks:

*Art 8516**5" 8573**Perf.**200 acid**Log # 2911**200 Gr*

RECORD

Cased in., ft.Sand Gas Oil Total Depth 8573

PRODUCTION

1st 24 hrs. Nat. 1st 24 hrs. after shot Gas Cu. Ft.Dry Hole Abandoned

Date

DEC 11 1946

19

S. J. F. WIS

Scout