

KANSAS

Section 22 Township 11 Range 18W

Well No. 6 Henderson

Company Lario Oil & Gas

Burnett

NORTH

					o		

WEST

EAST

SOUTH

2

Sec. 22 Twp. 11 R. 18W

Well No. #6 Henderson Farm

Lario Oil & Gas Company


Burnett Pool (Krime Drlg., Cont.)

330' Ft. from N. Line

_____ Ft. from S. Line

_____ Ft. from E. Line

990' Ft. from W. Line

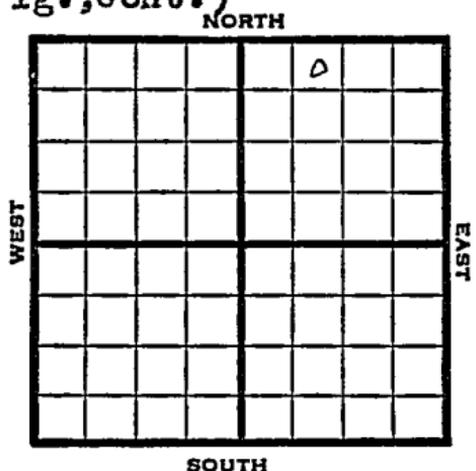

NE NW NE

1949 Elev. 1954' REPORT

9/21 Anhy 1277'
8" @ 1247'

9/28 Drlg 3154'

10/5 Arbuckle 3181'
Arvuckle 3500'
TD 3503
5"@ 3501'

10/12 Plug 3112
17 shots 3076-80
2500 acid
Swb 11 bbls oil PA 9 hrs.

10/19 " " " " " "

10/26 Lans 3181' Arb 3500'
5" @ 3501'
Perf Lans
500 acid
Pump 445 oil Pot.
Grav. 38°
TD 3503'

COMPLETED

Map No. _____ Sec. 22 Twp. 11 R. 18W

Well No. 6 Henderson

Lario Oil & Gas Company

Krime Drlg. Contractor

NE NW NE

FIRST REPORT
SECTION PLAT

330 Ft. from N. Line

_____ Ft. from S. Line

_____ Ft. from E. Line

990 Ft. from W. Line

			o

Ellis County

Location _____

Rig up _____

Drilling and Remarks:

Anhy 1277

8" @ 1247

RECORD

Cased _____ in., _____ ft.

Sand _____

Gas _____

Oil _____

Total Depth _____

PRODUCTION

1st 24 hrs. Nat. _____

1st 24 hrs. after shot _____

Gas _____ Cu. Ft.

Dry Hole _____

Abandoned _____

Date

SEP 21 1949 19

S. J. LEWIS Scout

Kansas

Map No. _____ Sec. 22 Twp. 11 R. 18WWell No. 6 Henderson "E"Larion Oil & Gas

Company

COMPLETE

Contractor

NE NW NE

E. 1954
SECTION PLAT330 Ft. from N. Line

_____ Ft. from S. Line

_____ Ft. from E. Line

990 Ft. from W. Line

		0	

Ellis County

Location _____

Rig up _____

Drilling and Remarks:

282 ft.

RECORD

Cased _____ in., _____ ft.

Sand _____

Gas _____

Oil _____

Total Depth 3523

PRODUCTION

1st 24 hrs. Nat. _____

1st 24 hrs. after shot _____

Gas _____ Cu. Ft.

Dry Hole _____

Abandoned _____

Date

OCT 26 1949

19

S. J. LEWIS

Scout