

Section 22 Township 11 Range 18WWell No. #2 HendersonCompany Mazda Oil etal

					0		

NORTH

WEST

EAST

SOUTH

7

Sec. 22 Twp. 11 R. 18W

Well No. #2 Henderson Farm

Mazda Oil et al Company
Burnett


 Ft. from N. Line

990 Ft. from S. Line

 Ft. from E. Line

990 Ft. from W. Line

NE SW NE

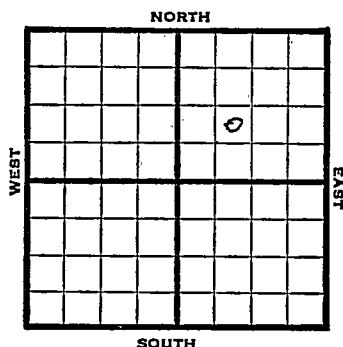

1947 Elev. 2010' REPORT

11/19 Location

11/25 RUR

12/3 8" @ 262'
Anhydrite 1292'
Drlg. 2700'

12/10 Topeka 2970'
Lansing 3241'
Arbuckle 3554-58' TD
5" @ 3555'

12/17 " "

12/30 TD 3560'
Swab 28 bbls. oil 1 hr.

1948
1/7 "

1/14 Arb. 3554'
5" @ 3555'
Depth Pot 1766 oil / 13% W
36.0 Gr.
TD 3560'

COMPLETED

Kansas

Map No. _____ Sec. 22 Twp. 11 R. 18WWell No. 2 HendersonMazda Oil etal. CompanyFIRST REPORT Contractor

NE SW NE

SECTION PLAT

		9	

_____ Ft. from N. Line

990 Ft. from S. Line

_____ Ft. from E. Line

990 Ft. from W. LineEllis. CountyLocation X

Rig up _____

Drilling and Remarks:

RECORD

Cased _____ in., _____ ft.

Sand _____

Gas _____

Oil _____

Total Depth _____

PRODUCTION

1st 24 hrs. Nat. _____

1st 24 hrs. after shot _____

Gas _____ Cu. Ft.

Dry Hole _____

Abandoned _____

Date

NOV 19 1947 19 S. J. LEWIS Scout

Map No. 71 Sec. 22 Twp. 11 R. 18W

Well No. 2 Henderson

Mazda Oil et al. Company

COMPLETE

Contractor

NE SW NE

E12010
SECTION PLAT

 Ft. from N. Line

990 Ft. from S. Line

 Ft. from E. Line

990 Ft. from W. Line

		o	

Ellis County

Location

Rig up

Drilling and Remarks:

Cr 80054

5103503

Depth 17660 ft

713 to W.

362 ft

RECORD

Cased in., ft.

Sand

Gas

Oil ✓

Total Depth 3560

PRODUCTION

1st 24 hrs. Nat.

1st 24 hrs. after shot

Gas Cu. Ft.

Dry Hole

Abandoned

Date

IAN 14 1948 19 S. J. LEWIS Scout