

**KANSAS**

**Ellis**

FORM 51 IOM 12-46 PETROL


Section 22 Township 11 Range 18-W

Well No. #1 Bean

Company Blair & Wakefield

**Burnett**

NORTH

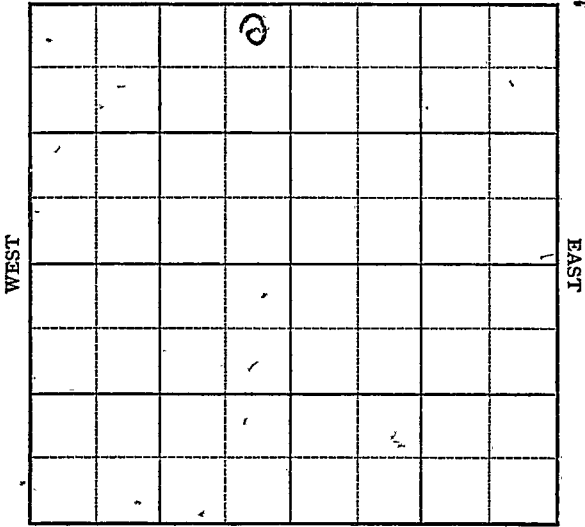


SOUTH



Sec. 22 Twp. 11 R. 18-W

Well No. 1 Bean Farm  
Blair & Wakefield Company

Burnett Pool  
330 Ft. from N. Line  
         Ft. from S. Line  
330 Ft. from E. Line  
         Ft. from W. Line  
**NE NW**

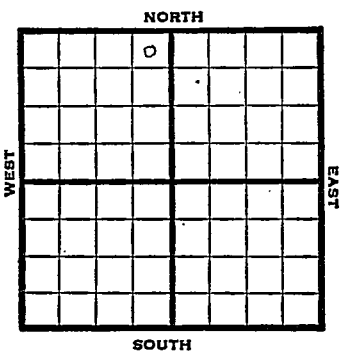

1947

**REPORT**

- 8/20 RUR
- 8/27 8" @ 198'  
Drlg. 2453'
- 9/3 Drlg 3342
- 9/10 Lansing 3165'  
Arbuckle 3462'-65TD  
5" @ 3463  
2200' oil 1 hr.
- 9/17 "
- 9/24 "
- 10/1 "
- 10/8 Swb 300 bbls oil in 5 hrs.
- 10/15 Arbuckle 3462  
5" @ 3463  
Echo Pot. 3000  
TD 3465  
Gravity 37

**COMPLETED**

Map No. \_\_\_\_\_ Sec. 22 Twp. 11 R. 18W

Well No. 1 Bean

Blair & Wakefield Company

FIRST REPORT Contractor

NE NW

SECTION PLAT

330 Ft. from N. Line

\_\_\_\_\_ Ft. from S. Line

330 Ft. from E. Line

\_\_\_\_\_ Ft. from W. Line

		o	
		.	

Ellis County

Location \_\_\_\_\_

Rig up \_\_\_\_\_

Drilling and Remarks:

R U R

RECORD

Cased \_\_\_\_\_ in., \_\_\_\_\_ ft.

Sand \_\_\_\_\_

Gas \_\_\_\_\_

Oil \_\_\_\_\_

Total Depth \_\_\_\_\_

PRODUCTION

1st 24 hrs. Nat. \_\_\_\_\_

1st 24 hrs. after shot \_\_\_\_\_

Gas \_\_\_\_\_ Cu. Ft.

Dry Hole \_\_\_\_\_

Abandoned \_\_\_\_\_

Date

AUG 20 1947

19

S. J. LEWIS

Scout

Map No. 71 Sec. 22 Twp. 11 R. 18W

Well No. 1 Dean

Blair & Wakefield Company

**COMPLETE**

Contractor

NE NW

*E 11927*  
**SECTION PLAT**

330 Ft. from N. Line

         Ft. from S. Line

330 Ft. from E. Line

         Ft. from W. Line

	0		

Ellis County

Location                                 

Rig up                                 

Drilling and Remarks:

*Cor 3462*  
*5' to 2463*  
*Echo B 3000*  
  
*27-2-42*

**RECORD**

Cased          in.,          ft.

Sand                                 

Gas                                 

Oil                                 

Total Depth *2465*

**PRODUCTION**

1st 24 hrs. Nat.                         

1st 24 hrs. after shot                         

Gas                          Cu. Ft.

Dry Hole                         

Abandoned                         

Date

OCT 15 1947 19

**S. J. LEWIS**

Scout