


Section 22 Township 11 Range 20W

Well No. #1 Zachman

Company Musgrove Pet.

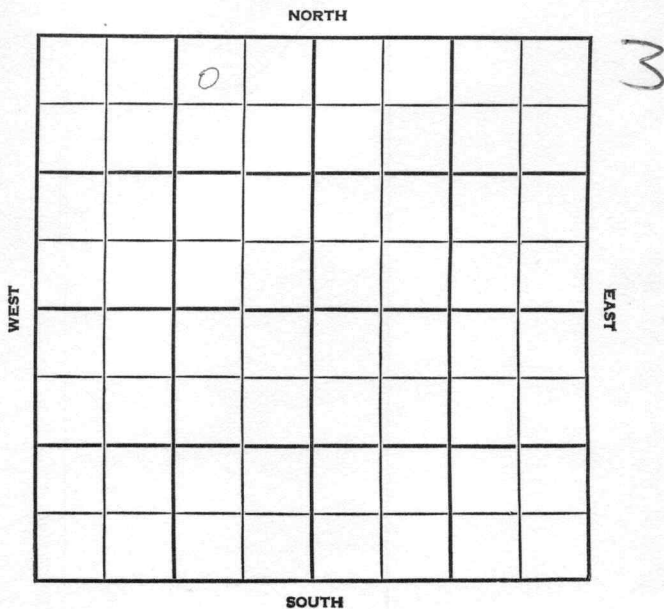

Ellis

KANSAS

SEC.

22

TWP.

11

R.

20W

WELL NO.

#1 Zachman

FARM

COMPANY

Musgrove Petr.

CONTRACTOR

Dutch George

Crum


\_\_\_\_ FT. FROM N. LINE

\_\_\_\_ FT. FROM S. LINE

\_\_\_\_ FT. FROM E. LINE

\_\_\_\_ FT. FROM W. LINE

NW NE NW

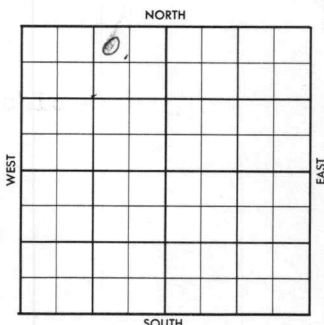

Sohio - F0

1956

ELEVATION

2089'

REPORT

7-18 MIR

8-8 Comm. 7-11-56  
8 5/8" @ 230 w/150  
Stuck @ 519

D &amp; A

H. 3354'; Tr. 3378'; L. 3394';

Log tops:

H. 3354'; Tr. 3377'; L. 3393';

BKG 3620'; C. 3677'; A. 3725';

TD 3751'

ABANDONED

County Ellis Elev. \_\_\_\_\_  
 Sec. 22 Twp. 11 Rge. 20W  
 Company Musgrove Pet.  
 Farm Name Zachman No. 1

| TOPS   | DEPTH | LOG | DATUM | Loc. in Sec. |
|--------|-------|-----|-------|--------------|
| Anh.   |       |     |       | NW NE NW     |
| Tr.    |       |     |       |              |
| H.     |       |     |       |              |
| Tr.    |       |     |       |              |
| Dg.    |       |     |       |              |
| B.L.   |       |     |       |              |
| L.     |       |     |       |              |
| K.C.   |       |     |       | Geol. _____  |
| B.K.C. |       |     |       | Contr. _____ |
| Ce.    |       |     |       | Dutch George |
| C.     |       |     |       |              |
| M.     |       |     |       | Pool         |
| M.     |       |     |       | Crum         |
| K.     |       |     |       |              |
| Mz.    |       |     |       |              |
| Mq.    |       |     |       |              |
| V.     |       |     |       |              |
| S.     |       |     |       |              |
| S.     |       |     |       |              |
| A.     |       |     |       |              |
| R.     |       |     |       |              |
| Pe.    |       |     |       |              |
| G.     |       |     |       |              |
| T.D.   |       |     |       |              |

FIRST REPORT

JUL 18 '56

Date Comm.

Sohio farmout

M I R

JUL 2 1956

R. G.

County Ellis Elev. 2089  
 Sec. 22 Twp. 11 Rge. 200  
 Company Wustrove Pet.  
 Farm Name Zachman No. 1

| TOPS   | DEPTH | LOG  | DATUM | Loc. in Sec. |
|--------|-------|------|-------|--------------|
| Anh.   |       |      |       | NW NE NW     |
| Tp.    |       |      |       |              |
| H.     | 3354  | 3354 |       |              |
| Tr.    | 3378  | 3377 |       |              |
| Dg.    |       |      |       |              |
| Bl.    |       |      |       |              |
| L.     | 3394  | 3393 |       | Geol.        |
| K.C.   |       |      |       | Contr.       |
| B.K.C. |       | 3620 |       | Dutch George |
| Ce.    |       |      |       | Pool         |
| C.     |       | 3677 |       | Crum         |
| M.     |       |      |       |              |
| M.     |       |      |       |              |
| K.     |       |      |       |              |
| Mz.    |       |      |       |              |
| Mq.    |       |      |       |              |
| V.     |       |      |       |              |
| S.     |       |      |       |              |
| S.     |       |      |       |              |
| A.     |       | 3725 |       |              |
| R.     |       |      |       |              |
| PE.    |       |      |       |              |
| G.     |       |      |       |              |
| TD.    | 3751  |      |       |              |

Date Comm. Sohio farmout

MT R JUL 25 '56 7-11-56 PTD 230

1150 stuck @ 519 PTD 2120

AUG 1 '56 # 3456 AUG 8 '56

DEA