


Section 22 Township 11 Range 23-W

Well Number 1 - Wilson

Company Watchorn

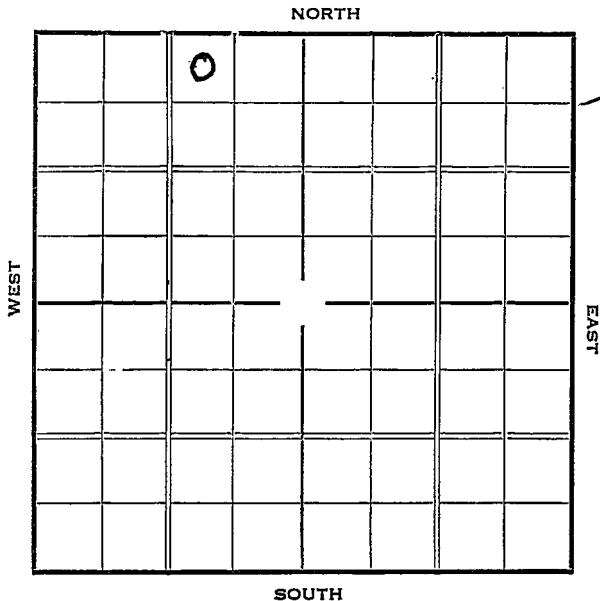

Sec. 22 Twp. 11 R. 23-W

Well No. #1 Wilson Farm  
Watchorn Company


330 Ft. from N. Line

\_\_\_\_\_ Ft. from S. Line

990 Ft. from E. Line

\_\_\_\_\_ Ft. from W. Line

**Elev. 2263**

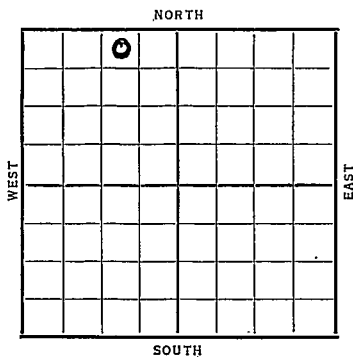

Date

REPORT

1937

5/12 10" @ 111'. WOC.

5/21 Drlg. 2701'.

5/28 7" @ 3486'. K.C. 3488-96'

T.D. 3496'. WOC.

6/4 T.D. 3500'. Est. 1 bbl.

oil per hr. C.O.

6/11 " " "

6/19 " " "

6/25 " " "

6/30 7" @ 3486'.

K. C. 3488'.

T.D. 3500'.

5000 acid.

Pot. 400 bbls.

**COMPLETED**

Trego KANSAS

Map No. 69 Sec. 22 Twp. 11 R. 23<sup>w</sup>

Well No. 1 - Wilson

Waterhorn Company

Contractor

### FIRST REPORT

### SECTION PLAT

350 Ft. from N. Line

\_\_\_\_\_ Ft. from S. Line

990 Ft. from E. Line

\_\_\_\_\_ Ft. from W. Line

	0		

Location \_\_\_\_\_

Rig up \_\_\_\_\_

Drilling and Remarks:

10" - 111 W.O.C.

### RECORD

Cased \_\_\_\_\_ in., \_\_\_\_\_ ft.

Sand \_\_\_\_\_

Gas \_\_\_\_\_

Oil \_\_\_\_\_

Total Depth \_\_\_\_\_

### PRODUCTION

1st 24 hrs. Nat. \_\_\_\_\_

1st 24 hrs. after shot \_\_\_\_\_

Gas \_\_\_\_\_ Cu. Ft.

Dry Hole \_\_\_\_\_

Abandoned \_\_\_\_\_

Date

M. D. Hatfield

MAY 22 1907 19

Scout

Trego KANSAS

Map No: 69 Sec. 22 Twp. 11 R. 23<sup>W</sup>Well No. 1 - WilsonWatchorn et al Company

Contractor

**COMPLETED**330 Ft. from N. Line

\_\_\_\_\_ Ft. from S. Line

990 Ft. from E. Line

\_\_\_\_\_ Ft. from W. Line

## SECTION PLAT

	0		

Location \_\_\_\_\_

Rig up \_\_\_\_\_

Drilling and Remarks:

5000 AcidPost - 400

## RECORD

Cased 7 in., 3486 ft.Sand K.C., 3488

Gas \_\_\_\_\_

Oil \_\_\_\_\_

Total Depth 3500

## PRODUCTION

1st 24 hrs. Nat. \_\_\_\_\_

1st 24 hrs. after shot \_\_\_\_\_

Gas \_\_\_\_\_ Cu. Ft.

Dry Hole \_\_\_\_\_

Abandoned \_\_\_\_\_

Date

JUN 30 1937H. D. Hatfield

Scout