


Section 22 Township 11 Range 23W

~~#1 Walker~~

Well No. ~~#2 Wilson~~

Company Porter Oil

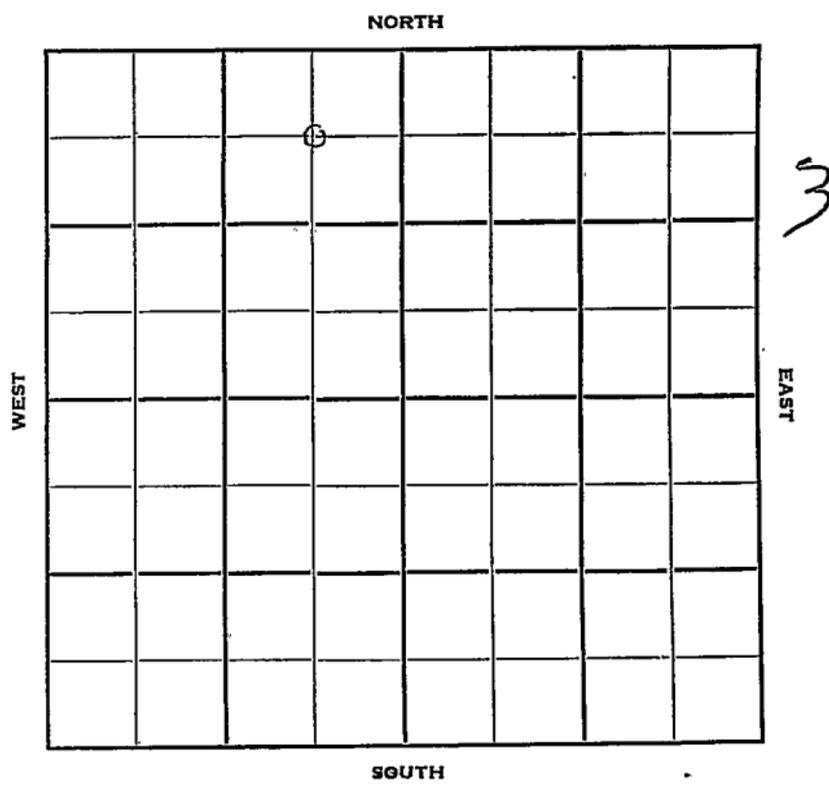

Trego

KANSAS

Sec. 22 Twp. II R. 23 W

Well No. # 1 Walker
2 Wilson Farm

Porter Oil Company

Peel Drlg. Contractor


660 Ft. from N. Line

_____ Ft. from S. Line

660 Ft. from E. Line

_____ Ft. from W. Line

C NE NW

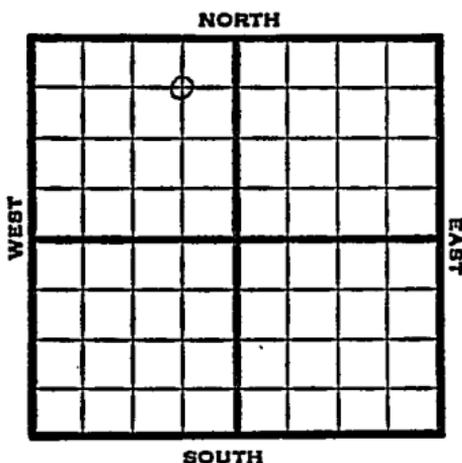

1951

Elev. 2264' REPORT

8/29

Location

10/3

Spud 9-12-51

D & A TD 4040'

8" @ 198' Heeb 3478' Lans. 3498'

DST 3504-20 open 1 hr. rec 215' fluid

DST 3520-38 open 1 hr. rec 8' mud

Arb. 4005-40' TD

D & A

ABANDONED


County Trego State Kansas

Sec. 22 (Blk. Twp.) 11 (Sur. Rge.) 23W Map No.

Operator Porter Oil

Well No. 2 Farm Wilson

Elev. _____ Location C NE NW

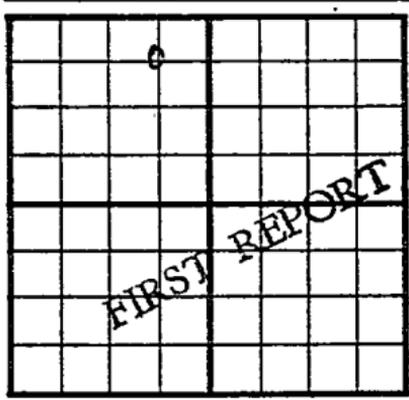

660 Ft. From N Line NW

660 Ft. From E Line Quarter

Ist. Report AUG 29 1951

Completion _____

Remarks _____

Spudding Date _____

Drlg. Data _____

Location _____

J. E. TYRA

County Trego State Kansas

Sec. 22 (Blk. Twp.) 11 (Sur. Rge.) 23W Map No.

Operator Porter Oil

Well No. 12 Farm Wilson Walker

Elev. 2264 Location C NE NW

660 Ft. From N Line NW

660 Ft. From E Line Quarter

Ist. Report

Completion OCT 3 1951

Remarks

Peel Drlg. - Contr.

Spudding Date 9-12-51

Drig. Data D & A TD 4040

8" @ 198 Heeb. 3478 Lans. 3498

DST 3504-20 open 1 hr. Rec. 215' fluid

DST 3520-38 open 1 hr. Rec. 8' mud

Arb. 4005-40 TD

D & A