

KANSAS

Wallace

FORM 51 5M 4-41 PETROL


Section 22 Township 11 Range 39-W

Well No. #1 Wallace Investment

Company Sinclair-Prairie

NORTH

Wildcat

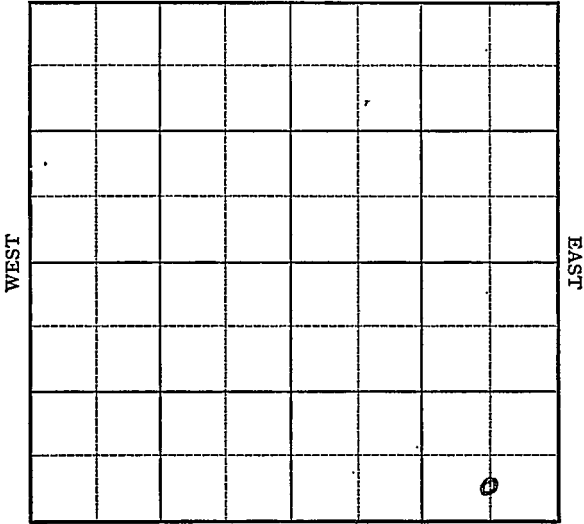

SOUTH

Sec. 22 Twp. 11 R. 39-W

Well No. #1 Wallace Investment Farm

Sinclair-Prairie Company

(Wildcat)


_____ Ft. from N. Line

330 Ft. from S. Line

660 Ft. from E. Line

_____ Ft. from W. Line

Elev. 3422

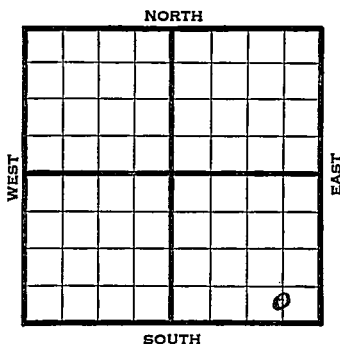

1942	REPORT
6/17	Location
6/24	Derrick.
7/1	Rotary.
7/8	13" - 241' Drlg. 1500'
7/15	Drlg. 3500'
7/22	Drlg. 3930'
7/29	4070 fsg Drill pipe.
8/5	" " "
8/12	to set Whipstock
8/19	" " "
8/27	Set Whipstock at 1840 Drlg 2890'
9/2	Drlg. 3574'
9/9	Drlg 3803
9/16	Drlg 4065
9/23	4094 stuck drill pipe
9/30	" " "
10/7	" " "
10/14	Lost Hole.
	T.D. 4094 ABANDONED.

Map No. MM Sec. 22 Twp. 11 R. 39W

Well No. 1 Wallace Investment

Sinclair-Prairie Company

FIRST REPORT

Contractor

C SL SE SE

SECTION PLAT

_____ Ft. from N. Line
330 Ft. from S. Line
660 Ft. from E. Line
 _____ Ft. from W. Line

WILDCAT

Location XXX
 Rig up _____
 Drilling and Remarks:

RECORD

Cased _____ in., _____ ft.
 Sand _____
 Gas _____
 Oil _____
 Total Depth _____

PRODUCTION

1st 24 hrs. Nat. _____
 1st 24 hrs. after shot _____
 Gas _____ Cu. Ft.
 Dry Hole _____
 Abandoned _____

Date

JUN 17 1942 19

S. J. LEWIS Scout

Wallace

KANSAS

Map No. NM Sec. 22 Twp. 11 R. 39WWell No. 1 Wallace InvestmentSinclair-Prairie CompanyABANDONED Contractor

C SL SE SE

 Ft. from N. Line330 Ft. from S. Line660 Ft. from E. Line Ft. from W. Line

SECTION PLAT

			o

WILDCAT

Location Rig up

Drilling and Remarks:

See J Note

RECORD

Cased in., ft.Sand Gas Oil Total Depth 4094

PRODUCTION

1st 24 hrs. Nat. 1st 24 hrs. after shot Gas Cu. Ft.Dry Hole Abandoned

Date

OCT 14 1942

19

S. J. LEWIS

Scout