


Section 22 Township 11 Range 17-W

Well Number 4 Bemis "C"


Company Margay Oil

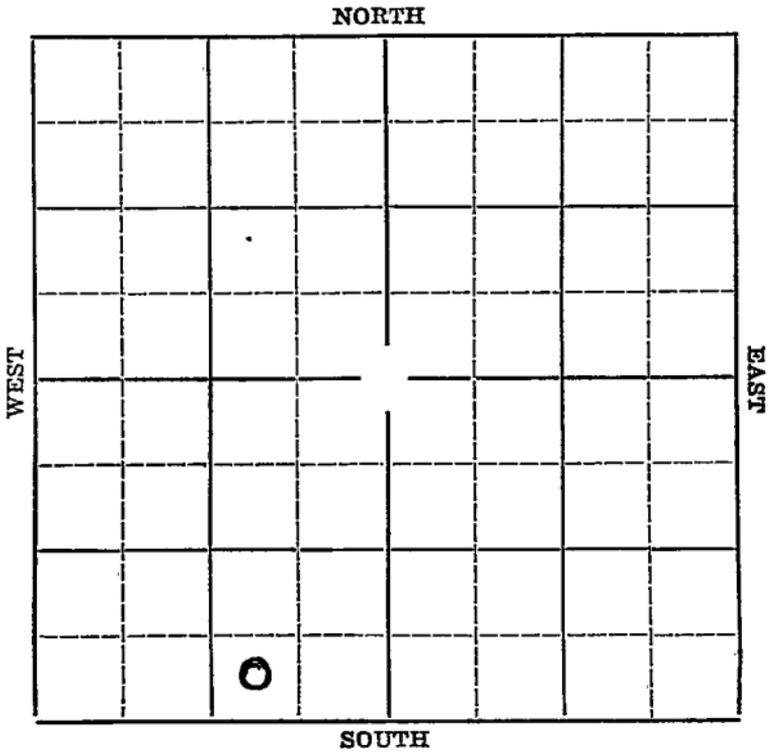

Sec. 22 Twp. 11 R. 17-W

Well No. #4 Bemis "C" Farm _____
Margay Oil Company _____

_____ Ft. from N. Line
330 Ft. from S. Line
990 Ft. from E. Line
 _____ Ft. from W. Line
 Elev. 2056

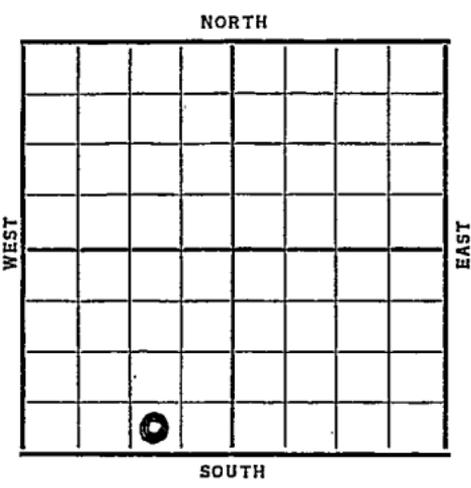

Date	REPORT
1937	
4/21	Location
4/30	B. R. Rig
5/7	Rig'n up.
5/14	18" @ 24'. Drlg. 800'.
5/21	Drlg. 2154'.
5/28	Drlg. 2772'.
6/4	Drlg. 3389'.
6/11	Sil. & 7" @ 3516'.
	T.D. 3517'. Bailing.
6/16	7" @ 3516'.
	Sil. 3516'.
	T.D. 3534'.
	Pot. 2496 bbls. 24 hrs.
	Natural. Down 2 hrs.
	COMPLETED

KANSAS *Ellis*Map No. _____ Sec. 22 Twp. 11 R. 17WWell No. 4 Bemis "C"Margay Oil Company_____
Contractor

SECTION PLAT

Ft. from N. Line320 Ft. from S. Line990 Ft. from E. Line_____
Ft. from W. Line

FIRST REPORT

Location ✓

Rig up _____

Drilling and Remarks:

RECORD

Cased _____ in., _____ ft.

Sand _____

Gas _____

Oil _____

Total Depth _____

PRODUCTION

1st 24 hrs. Nat. _____

1st 24 hrs. after shot _____

Gas _____ Cu. Ft.

Dry Hole _____

Abandoned _____

Date

APR 21 1937 19S. I. LEWIS Scout

Ellis KANSAS

Map No. 71 Sec. 22 Twp. 11 R. 17^w

Well No. 4 Bennie "C"

Margay Company
Contractor

COMPLETED

SECTION PLAT

_____ Ft. from N. Line

330 Ft. from S. Line

990 Ft. from E. Line

_____ Ft. from W. Line

Location _____

Rig up _____

Drilling and Remarks:

Pat 2496/24
NAT,
Down 2 hrs

RECORD

Cased 7 in., 3516 ft.

Sand Si 3516

Gas _____

Oil _____

Total Depth 3534

PRODUCTION

1st 24 hrs. Nat. _____

1st 24 hrs. after shot _____

Gas _____ Cu. Ft.

Dry Hole _____

Abandoned _____

Date

JUN 16 1937 19

H. D. Hatfield Scout