


Section 22 Township 11 Range 17-W

Well Number 5 - Bemis "C"

Company Margay

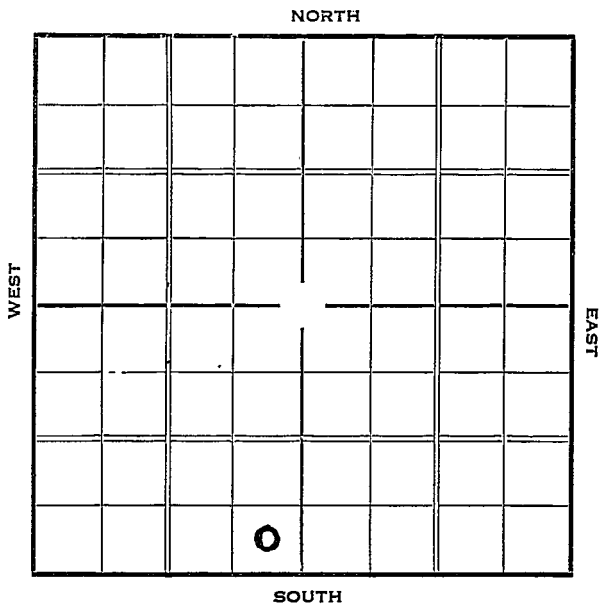



Map No. 71 Sec. 22 Twp. 11 R. 17<sup>w</sup>Well No. 5 - Bernis "C"Margay Company

Contractor

## FIRST REPORT

## SECTION PLAT

\_\_\_\_\_ Ft. from N. Line

330 Ft. from S. Line330 Ft. from E. Line

\_\_\_\_\_ Ft. from W. Line


Location \_\_\_\_\_

Rig up \_\_\_\_\_

Drilling and Remarks:

B, Rot, Rig

## RECORD

Cased \_\_\_\_\_ in., \_\_\_\_\_ ft.

Sand \_\_\_\_\_

Gas \_\_\_\_\_

Oil \_\_\_\_\_

Total Depth \_\_\_\_\_

## PRODUCTION

1st 24 hrs. Nat. \_\_\_\_\_

1st 24 hrs. after shot \_\_\_\_\_

Gas \_\_\_\_\_ Cu. Ft.

Dry Hole \_\_\_\_\_

Abandoned \_\_\_\_\_

Date

JULY 5 - 1937

19

H. D. Hatfield Scout

*Ellis* KANSAS

Map No. 71 Sec. 22 Twp. 11 R. 17<sup>w</sup>

Well No. 5- Bernis "C"

Margay Company  
Contractor

**COMPLETED**

**SECTION PLAT**

\_\_\_\_\_ Ft. from N. Line

330 Ft. from S. Line

330 Ft. from E. Line

\_\_\_\_\_ Ft. from W. Line

		0	

Location \_\_\_\_\_

Rig up \_\_\_\_\_

Drilling and Remarks:

*Pat. 2565/24*

**RECORD**

Cased 7 in., 3444 ft.

Sand S11 3444

Gas \_\_\_\_\_

Oil \_\_\_\_\_

Total Depth 3462

**PRODUCTION**

1st 24 hrs. Nat. \_\_\_\_\_

1st 24 hrs. after shock \_\_\_\_\_

Gas \_\_\_\_\_ Cu. Ft.

Dry Hole \_\_\_\_\_

Abandoned \_\_\_\_\_

Date

JUN 16 1937 19

H. D. Hatfield Scout