


Section 22 Township 11 Range 17-W

Well Number 3 - Johansen

Company Margay

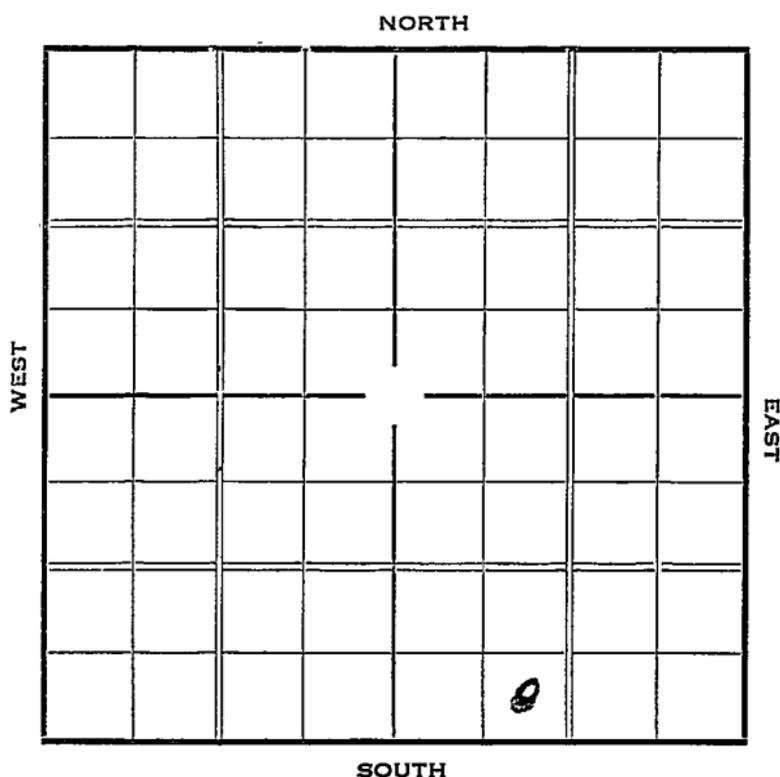

KANSAS Ellis

Form 252-A-5M-7-36-Palace

Sec. 22 Twp. 11 R. 17-W

Well No. #3 Johansen Farm

Margay Company


_____ Ft. from N. Line

330 Ft. from S. Line

_____ Ft. from E. Line

990 Ft. from W. Line

Elev. 1972

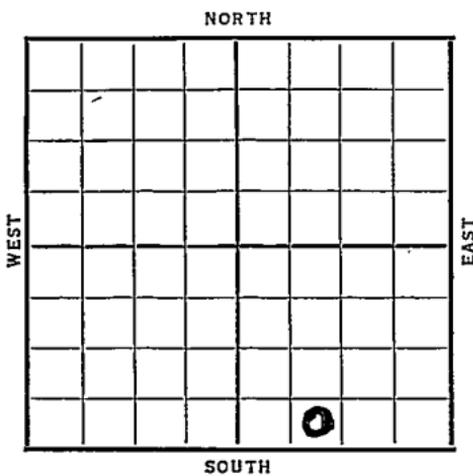

Date	REPORT
1937	
7/14	Cellar
7/23	"
7/30	"
8/6	"
8/13	Cellar.
8/20	"
8/28	16" @ 32'. Anhy 1183'.
	10" @ 1183'. Drlg. 2042'.
9/3	Drlg. 2860'.
9/10	Drlg. 3320'.
9/15	7" @ 3424'
	Sil 3425'
	TD 3432'
	P - 425/4 & 420/4
	Pot 2520
	COMPLETED

Ellis KANSAS

Map No. _____ Sec. 22 Twp. 11 R. 17^w

Well No. 3-Johansen

Margay Company

Contractor

FIRST REPORT

SECTION PLAT

_____ Ft. from N. Line
330 Ft. from S. Line
 _____ Ft. from E. Line
990 Ft. from W. Line

			0

Location _____

Rig up _____

Drilling and Remarks:

Cellar

RECORD

Cased _____ in., _____ ft.

Sand _____

Gas _____

Oil _____

Total Depth _____

PRODUCTION

1st 24 hrs. Nat. _____

1st 24 hrs. after shot _____

Gas _____ Cu. Ft.

Dry Hole _____

Abandoned _____

Date

JUL 14 1937

H. D. Hatfield Scout

Ellis KANSAS

Map No. _____ Sec. 22 Twp. 11 R. 17^W

Well No. 3-Johansen

Margay Company

Contractor

COMPLETED

SECTION PLAT

			0

_____ Ft. from N. Line

330 Ft. from S. Line

_____ Ft. from E. Line

990 Ft. from W. Line

Location _____

Rig up _____

Drilling and Remarks:

R- 425/4 + 420/4
Pot - 2520

RECORD

Cased 7 in., 3424 ft.

Sand 511 3425

Gas _____

Oil _____

Total Depth 3432

PRODUCTION

1st 24 hrs. Nat. _____

1st 24 hrs. after shot _____

Gas _____ Cu. Ft.

Dry Hole _____

Abandoned _____

Date

SEP 15 1937

19

H. D. Hatfield Scout