


Section 22 Township 11 Range 17-W

Well Number 7 Bemis


Company British-American

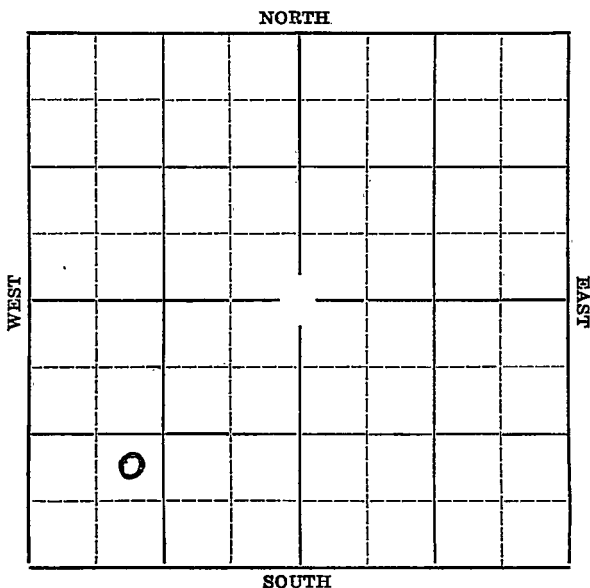

Sec. 22 Twp. 11 R. 17-W

Well No. #7 Bemis Farm
British-American Company

_____ Ft. from N. Line
990 Ft. from S. Line
 _____ Ft. from E. Line
990 Ft. from W. Line
 Elev. 1993

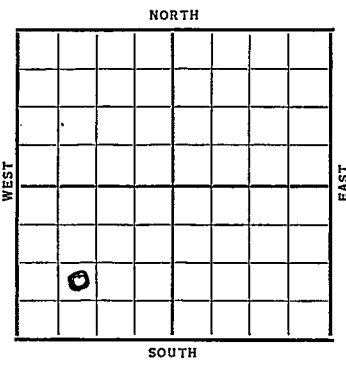

Date	REPORT
1937	
4/21	Rig
4/30	15" @ 148'. Drlg. 1215'.
5/7	Anhy 1195'. Drlg. 2310'.
5/14	Drlg. 3175'.
5/21	Sil. 3467-71'.
	7" @ 3471' T.D.
5/28	RUST.
6/4	T.D. 3482'.
6/9	7" @ 3471'.
	Sil. 3467'.
	T.D. 3482'.
	Pot. 2827 bbls. Nat.
	COMPLETED

KANSAS *Ellis*

Map No. _____ Sec. 22 Twp. 11 R. 17W

Well No. 7 Bemis

British-American Company

Contractor _____

SECTION PLAT

o			

_____ Ft. from N. Line

990 Ft. from S. Line

_____ Ft. from E. Line

990 Ft. from W. Line

FIRST REPORT

Location _____

Rig up _____

Drilling and Remarks:

Rig

RECORD

Cased _____ in., _____ ft.

Sand _____

Gas _____

Oil _____

Total Depth _____

PRODUCTION

1st 24 hrs. Nat. _____

1st 24 hrs. after shot _____

Gas _____ Cu. Ft.

Dry Hole _____

Abandoned _____

Date

APR 21 1937

19

S. J. LEWIS Scout

Ellis KANSAS

Map No. 71 Sec. 22 Twp. 11 R. 17^w

Well No. 7-Bennis

British American Company

Contractor

COMPLETED

SECTION PLAT

_____ Ft. from N. Line

990 Ft. from S. Line

_____ Ft. from E. Line

990 Ft. from W. Line

0			

Location _____

RECORD

Cased 7 in., 347 ft.

Sand 513467

Gas _____

Oil _____

Total Depth 3482

Rig up _____

Drilling and Remarks:

Pat-2827

NZT

PRODUCTION

1st 24 hrs. Nat. _____

1st 24 hrs. after shot _____

Gas _____ Cu. Ft.

Dry Hole _____

Abandoned _____

Date

JUN 9 1937 19 H. D. Hatfield Scout