


Section 22 Township 11 Range 17-W

Well Number #2-Bemis "A"

Company Ryan Consolidated

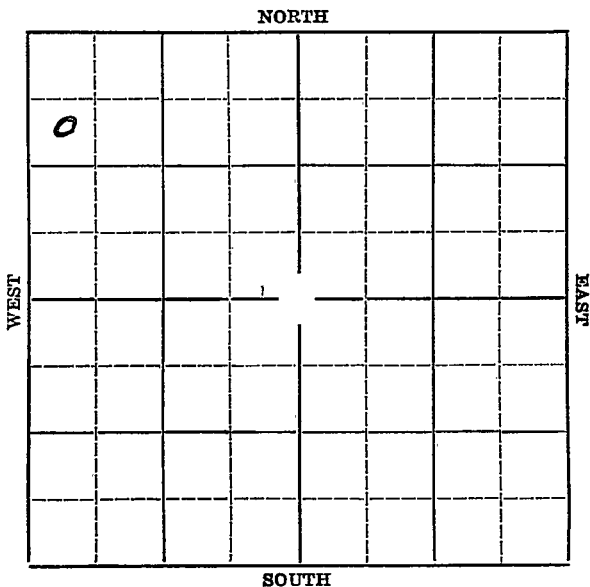

Sec. 22 Twp. 11 R. 17W

Well No. #2 Bemis "A" Farm
Ryan Consolidated Company


990' Ft. from N. Line

_____ Ft. from S. Line

_____ Ft. from E. Line

330' Ft. from W. Line

Elev. 1880

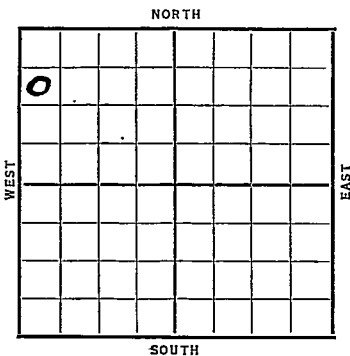

Date	REPORT
1936	
8/19	Rig on ground.
8/27	Rig.
9/3	15" @ 108'. Waiting on cement.
9/10	Anhydrate 1089'. Drlg. 1570'.
9/18	2955'. Shut down.
9/24	3088' fishing.
10/1--	
10/8	Shut down.
10/15	Plug back to 1400'. Drilling
	ahead at 2410'.
10/22	Drlg. 2750'.
10/29	Drlg. 3215'.
11/6	Sil. 3397 set 6"
	Clean out
11/10	Sil 3396 T. D. 3401
	Pump 2030
	<u>COMPLETED</u>

Map No. 71 Sec. 22 Twp. 11 R. 17WWell No. 2 Bemis "A"Ryan Consolidated Company

Contractor

SECTION PLAT

990 Ft. from N. Line

_____ Ft. from S. Line

_____ Ft. from E. Line

330 Ft. from W. Line

FIRST REPORT

Location _____

Rig up _____

Drilling and Remarks:

ROY

RECORD

Cased _____ in., _____ ft.

Sand _____

Gas _____

Oil _____

Total Depth _____

PRODUCTION

1st 24 hrs. Nat. _____

1st 24 hrs. after shot _____

Gas _____ Cu. Ft.

Dry Hole _____

Abandoned _____

Date

AUG 19 1936 19

S. J. LEWIS

Scout

KANSAS

Map No. 71 Sec. 22 Twp. 11 R. 12W

Well No. 2 Bemis "A"

Ryan Consolidated Company

Contractor

SECTION PLAT

0			

990 Ft. from N. Line

_____ Ft. from S. Line

_____ Ft. from E. Line

320 Ft. from W. Line

COMPLETED.

Location _____

Rig up _____

Drilling and Remarks:

Sil 3396

Pump 2020

RECORD

Cased _____ in., _____ ft.

Sand _____

Gas _____

Oil _____

Total Depth 3401

PRODUCTION

1st 24 hrs. Nat. _____

1st 24 hrs. after shot _____

Gas _____ Cu. Ft.

Dry Hole _____

Abandoned _____

Date

NOV 10 1936 19

S. J. LEWIS Scout