

KANSAS


Ellis

Form 51—5M—7-39—Palace

Section 22 Township 11 Range 17W

Well No. #7 Bemis "A"

Company Ryan Consolidated

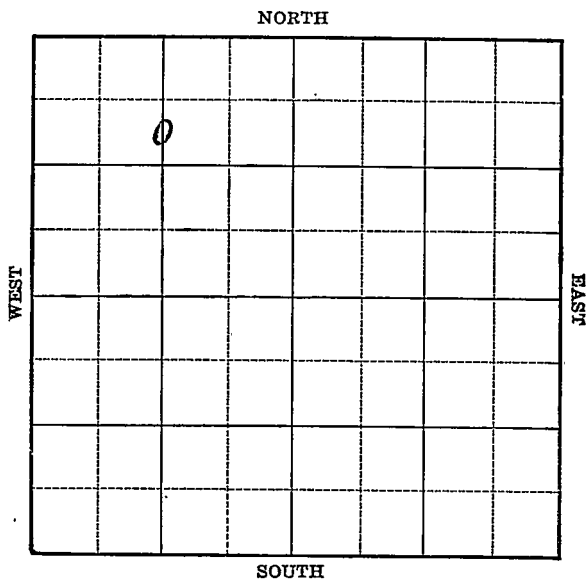

Sec. 22 Twp. 11 R. 17-W

Well No. #7 Bemis "A" Farm

Ryan Consolidated

Company

(Bemis)


990 Ft. from N. Line

Ft. from S. Line

Ft. from E. Line

1320 Ft. from W. Line

Elev. 1902

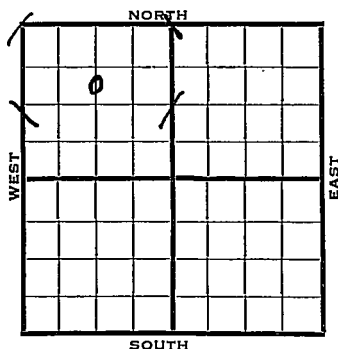[illegible]

Map No. 71 Sec. 22 Twp. 11 R. 17WWell No. 7 Bemis "A"Ryan Consolidated

Company


Contractor

FIRST REPORT

C S L N $\frac{1}{2}$ NW990 Ft. from N. Line Ft. from S. Line Ft. from E. Line1320 Ft. from W. Line

BEMIS POOL

SECTION PLAT

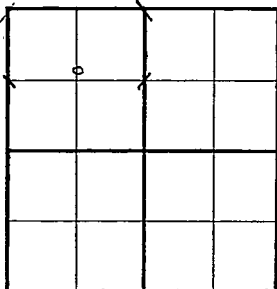Location Rig up

Drilling and Remarks:

Derrick

RECORD

Cased in., ft.Sand Gas Oil Total Depth

PRODUCTION

1st 24 hrs. Nat. 1st 24 hrs. after shot Gas Cu. Ft.Dry Hole Abandoned

Date

JUL 2 1940 19S. J. LEWIS Scout


Map No. 71 Sec. 22 Twp. 11 R. 17WWell No. 7 Bemis "A"Ryan Consolidated Company

Contractor

COMPLETED

C S L N $\frac{1}{2}$ NW990 Ft. from N. Line Ft. from S. Line Ft. from E. Line1320 Ft. from W. Line

SECTION PLAT

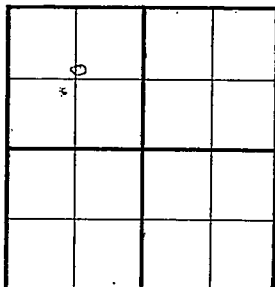

BEMIS POOL

Location Rig up

Drilling and Remarks:

*Art 3412**5" C 3412**P. B 3418**Eckometer 24**2313*

RECORD

Cased in., ft.Sand Gas Oil Total Depth 3422

PRODUCTION

1st 24 hrs. Nat. 1st 24 hrs. after shot Gas Cu. Ft.Dry Hole Abandoned

Date

AUG 7 1940 19S. J. LEWIS Scout