


Section 22 Township 11 Range 17W

Well No. #8 Bemis "B"

Company Ryan Consolidated

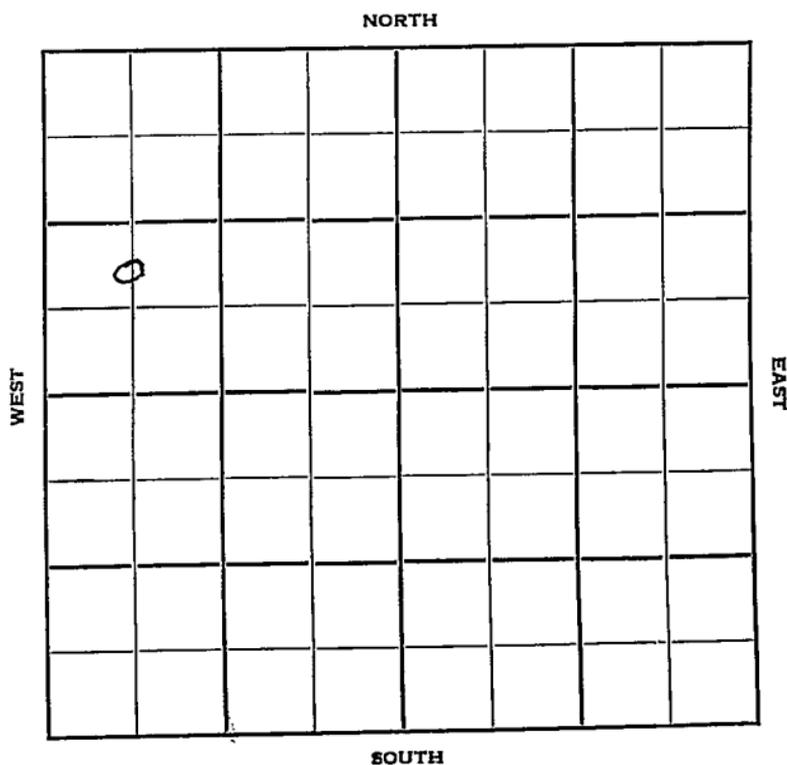

Sec. 22 Twp. 11 R. 17W

Well No. #8 Bemis "B" Farm

Ryan Consolidated Company

Contractor


Ft. from N. Line

990' Ft. from S. Line

Ft. from E. Line

660' Ft. from W. Line

C N L SW NW

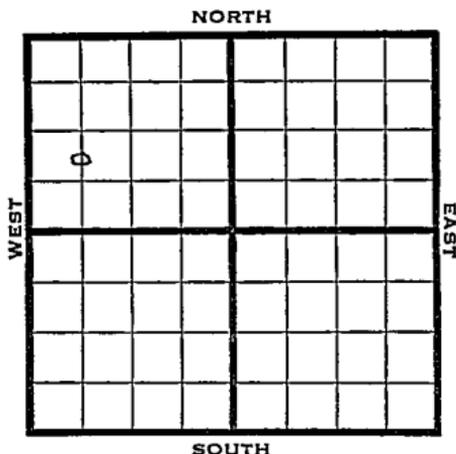

1950

Elev. 1915' REPORT

2/8

Arb. 3415'
TD 3482'
9 shots 3415-33
Show oil
Testing

6/7

Arb 3415'
Perf 12/345-55
P 15 BOPD 50% wtr
TD 3482'

COMPLETED

Kansas

Map No. _____ Sec. 22 Twp. 11 R. 17W

Well No. 8 Bemis "B"

Ryan Consolidated Company

Contractor

C N L SW NW

El. 1915
SECTION PLAT

_____ Ft. from N. Line

990 Ft. from S. Line

_____ Ft. from E. Line

660 Ft. from W. Line

o			
FIRST REPORT			

Ellis County

Location _____

Rig up _____

Drilling and Remarks:

Arb. ^{5'} 3415

TD 3482

9 shots 3415-33

show of oil

testing

RECORD

Cased _____ in., _____ ft.

Sand _____

Gas _____

Oil _____

Total Depth _____

PRODUCTION

1st 24 hrs. Nat. _____

1st 24 hrs. after shot _____

Gas _____ Cu. Ft.

Dry Hole _____

Abandoned _____

Date

FEB 8 1950 19

J. E. TYRA Scout

Kansas

Map No. _____ Sec. 22 Twp. 11 R. 17W

Well No. 8 Bemis "B"

Ryan Consolidated Company

R Contractor
C N L SW NW El. 1915

SECTION PLAT

_____ Ft. from N. Line

990 Ft. from S. Line

_____ Ft. from E. Line

660 Ft. from W. Line

	COMPLETE		
o			

Ellis

Location _____

Rig up _____

Drilling and Remarks:

*Drub 3 7/15
perf 12/345-55
P15 BOPD
50% wtr.
C*

RECORD

Cased _____ in., _____ ft.

Sand _____

Gas _____

Oil _____

Total Depth 3482

PRODUCTION

1st 24 hrs. Nat. _____

1st 24 hrs. after shot _____

Gas _____ Cu. Ft.

Dry Hole _____

Abandoned _____

Date

JUN 7 1950 19

J. E. TYRA Scout