


Section 22 Township 11 Range 17-W

Well No. 8 Johansen

Company Magnolia

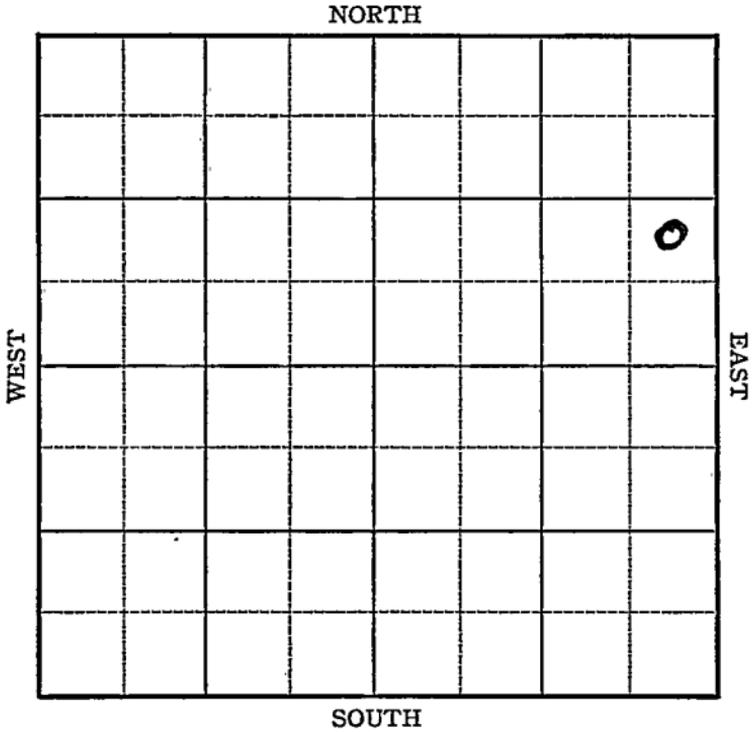

Sec. 22 Twp. 11 R. 17-W

Well No. #8 - Johansen Farm
Magnolia Company


 Ft. from N. Line

990 Ft. from S. Line

330 Ft. from E. Line

 Ft. from W. Line

Elev. 1894

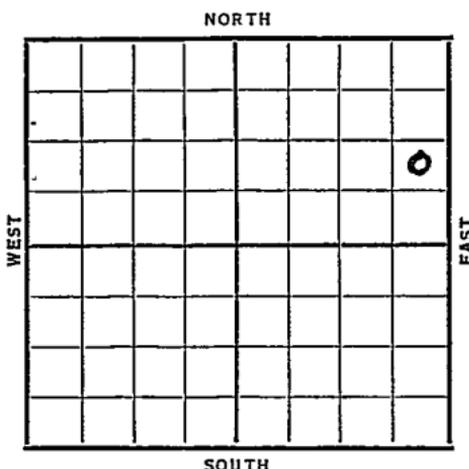

Date	REPORT
1937	
11/10	Location
11/19	R. R.
11/26	"
12/3	R U R
12/10	16" @ 54'. Drlg. 100'.
12/17	Anhy 1120'. 10" @ 1140'.
	Drlg. 1165'.
12/24	Drlg. 2870'.
12/31	Drlg. 3260'.
1938	
1/7	Arb. & 7" @ 3372'.
	800' oil @ 3374 & Swab 40 bbls.
	oil in 4 hrs. T.D. 3378'.
	Clean out.
	OVER

1938

1/12

7" @ 3372'.

Arb. 3372'.

T.D. 3378'.

2000 acid.

Potential 2565 bbls.

COMPLETED

Ellis KANSAS

Map No. _____ Sec. 22 Twp. 11 R. 17WWell No. 8 JohansenMagnolia

Company _____

Contractor _____

FIRST REPORT

SECTION PLAT

NE SE NE

_____ Ft. from N. Line

990 Ft. from S. Line330 Ft. from E. Line

_____ Ft. from W. Line

			0

Location X

Rig up _____

Drilling and Remarks:

RECORD

Cased _____ in., _____ ft.

Sand _____

Gas _____

Oil _____

Total Depth _____

PRODUCTION

1st 24 hrs. Nat. _____

1st 24 hrs. after shot _____

Gas _____ Cu. Ft.

Dry Hole _____

Abandoned _____

Date

NOV 10 1937 19

H. D. Hatfield

Scout

Ellis KANSAS

Map No. 71 Sec. 22 Twp. 11 R. 17W

Well No. 8 Johansen

Magnolia Petroleum Company

Contractor

~~NOT COMPLETED~~

SECTION PLAT

NE SE NE

_____ Ft. from N. Line

990 Ft. from S. Line

330 Ft. from E. Line

_____ Ft. from W. Line

			0

Location _____

Rig up _____

Drilling and Remarks:

2000 acid

Pot-2565

RECORD

Cased 7 in., 3372 ft.

Sand Arb 3372

Gas _____

Oil _____

Total Depth 3378

PRODUCTION

1st 24 hrs. Nat. _____

1st 24 hrs. after shot _____

Gas _____ Cu. Ft.

Dry Hole _____

Abandoned _____

Date

JAN 12 1938 19

H. D. Hatfield Scout