


Section 22 Township 11- Range 17-W

Well No. 6 - Bemis "B"

Company Ryan Consolidated

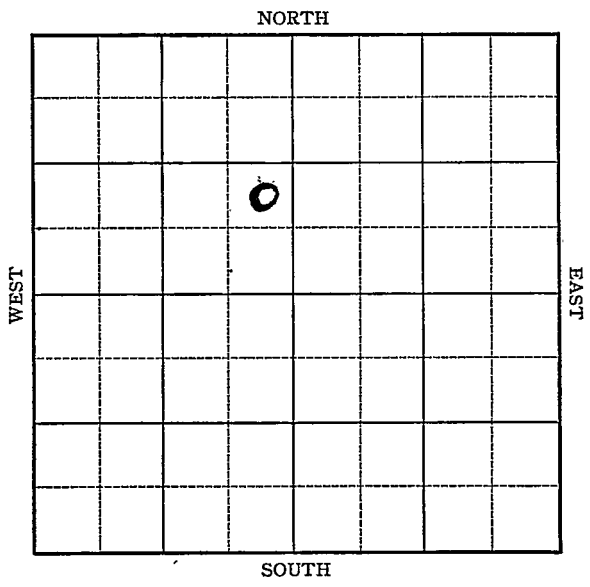

Sec. 22 Twp. 11 R. 17-W

Well No. #6 Bemis "B" Farm


Ryan Consolidated Company

_____ Ft. from N. Line

990 Ft. from S. Line

330 Ft. from E. Line

_____ Ft. from W. Line

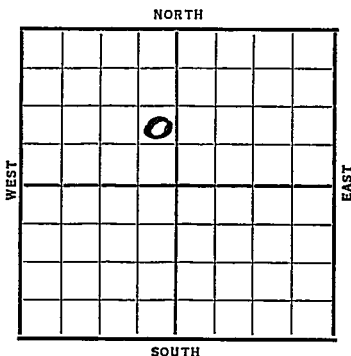

Elev. 1929

Date	REPORT
1937	
8/4	Cellar
8/13	R. O. G.
8/20	R. R.
8/28	"
9/3	"
9/10	"
9/17	"
9/24	M. I. T.
10/2	15" @ 30'. Anhy 1142'.
	10" @ 1146'. WOC.
10/8	Drl g. 2675'.
10/15	Drl g. 3350'.
10/22	Sil. 3437' & 7". T.D. 3447'.
	2800' oil in 30 min.
	OVER

1937

10/27 7" @ 3437'.

Sil. 3437'.

T.D. 3447'.

Potential 2873 bbls, Nat.

COMPLETED

Ellis KANSASMap No. _____ Sec. 22 Twp. 11 R. 17 WWell No. 6-Bemis "B"Ryan Consolidated Company
Contractor

FIRST REPORT

SECTION PLAT

_____ Ft. from N. Line

990 Ft. from S. Line330 Ft. from E. Line

_____ Ft. from W. Line

	0		

Location _____

Rig up _____

Drilling and Remarks:

Cellar

RECORD

Cased _____ in., _____ ft.

Sand _____

Gas _____

Oil _____

Total Depth _____

PRODUCTION

1st 24 hrs. Nat. _____

1st 24 hrs. after shot _____

Gas _____ Cu. Ft.

Dry Hole _____

Abandoned _____

Date

AUG 4 - 1937 19 H. D. Hatfield Scout

Map No. _____ Sec. 22 Twp. 11 R. 17WWell No. 6 Bemis "B"Ryan Consolidated Company_____
Contractor**COMPLETED**
NE SE NW**SECTION PLAT**

	0		
			1.

_____ Ft. from N. Line

990 Ft. from S. Line330 Ft. from E. Line

_____ Ft. from W. Line

Location _____

Rig up _____

Drilling and Remarks:

*POT-2873**Wat***RECORD**Cased 7 in., 3437 ft.Sand 511 3437

Gas _____

Oil _____

Total Depth 3447**PRODUCTION**

1st 24 hrs. Nat. _____

1st 24 hrs. after shot _____

Gas _____ Cu. Ft.

Dry Hole _____

Abandoned _____

Date

OCT 27 1937 19H. D. Hatfield Scout