


Section 22 Township 11 Range 17-W

Well Number 1 Bemis "C"

Company Margay Oil.

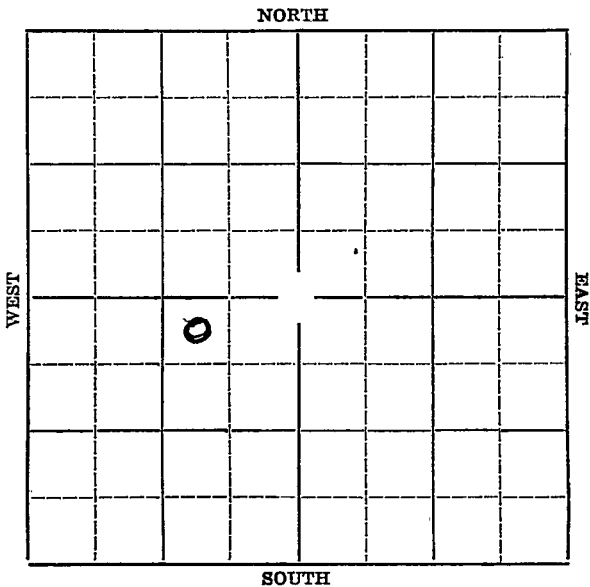

Sec. 22 Twp. 11 R. 17-W

Well No. #1 Bemis "C" Farm \_\_\_\_\_  
Margay Oil Company \_\_\_\_\_


330 Ft. from N. Line

\_\_\_\_\_ Ft. from S. Line

990 Ft. from E. Line

\_\_\_\_\_ Ft. from W. Line

Elev. 1944

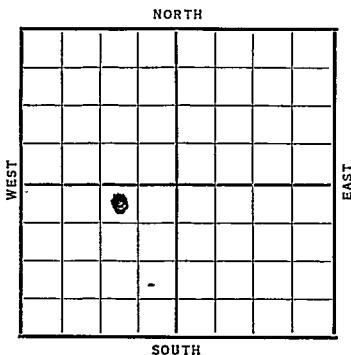

~~1937~~

REPORT

3/3

Rig

3/11

16" @ 96'. Drlg. 100'.

3/18

Anhydrate 1153'.

10" @ 1159 WOC

3/25

Drlg. 2450'.

4/2

Drlg. 3237'

4/8

Sil 3442' Set 6" WOC

4/14

Sil. 3442'.

T.D. 3459'.

Potential 2347.

**COMPLETED**

Map No. 71 Sec. 22 Twp. 11 R. 17W

Well No. 1 Bemis "C"

Margay Oil Company

Contractor

**SECTION PLAT**

330 Ft. from N. Line

     Ft. from S. Line

990 Ft. from E. Line

     Ft. from W. Line

	o		

**FIRST REPORT**

Location \_\_\_\_\_

Rig up \_\_\_\_\_

Drilling and Remarks:

*Rig*

**RECORD**

Cased \_\_\_\_\_ in., \_\_\_\_\_ ft.

Sand \_\_\_\_\_

Gas \_\_\_\_\_

Oil \_\_\_\_\_

Total Depth \_\_\_\_\_

**PRODUCTION**

1st 24 hrs. Nat. \_\_\_\_\_

1st 24 hrs. after shot \_\_\_\_\_

Gas \_\_\_\_\_ Cu. Ft.

Dry Hole \_\_\_\_\_

Abandoned \_\_\_\_\_

Date

MAR 3 1937 19

S. J. LEWIS Scout

Map No. \_\_\_\_\_ Sec. 22 Twp. 11 R. 17W

Well No. 1 Bemis "C"

Margay Oil Company

\_\_\_\_\_  
Contractor

**SECTION PLAT**

230 Ft. from N. Line

\_\_\_\_\_ Ft. from S. Line

990 Ft. from E. Line

\_\_\_\_\_ Ft. from W. Line

	0		

**COMPLETED**

**RECORD**

Location \_\_\_\_\_

Cased \_\_\_\_\_ in., \_\_\_\_\_ ft.

Rig up \_\_\_\_\_

Sand \_\_\_\_\_

Drilling and Remarks:

Gas \_\_\_\_\_

*Sil 3442*

Oil \_\_\_\_\_

Total Depth 3459

*Potential*

**PRODUCTION**

*2347*

1st 24 hrs. Nat. \_\_\_\_\_

1st 24 hrs. after shot \_\_\_\_\_

Gas \_\_\_\_\_ Cu. Ft.

Dry Hole \_\_\_\_\_

Abandoned \_\_\_\_\_

Date

APR 14 1937 19

**S. J. LEWIS** Scout