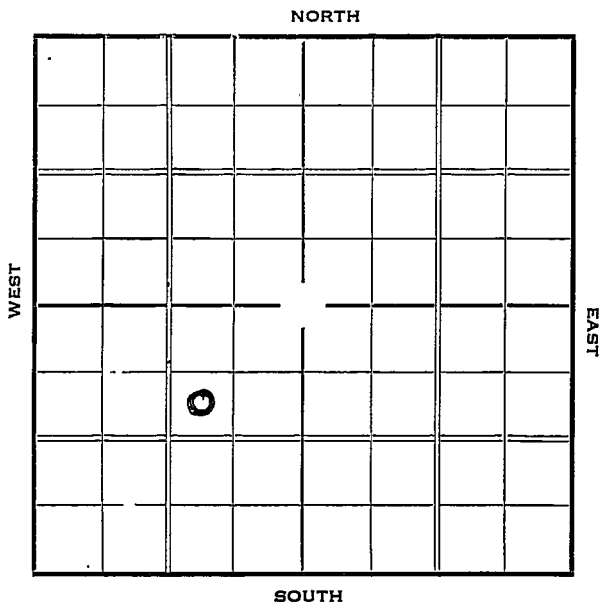


Section 22 Township 11 Range 17-WWell Number 2- "C" BemisCompany Margay Oil

KANSAS*Ellis*Map No. 71 Sec. 22 Twp. 11 R. 17WWell No. 2-C BenisMargay Oil CompanySJ Contractor**SECTION PLAT**

	o		

990 Ft. from N. Line

_____ Ft. from S. Line

990 Ft. from E. Line

_____ Ft. from W. Line

FIRST REPORTLocation ✓

Rig up _____

Drilling and Remarks:

RECORD

Cased _____ in., _____ ft.

Sand _____

Gas _____

Oil _____

Total Depth _____

PRODUCTION

1st 24 hrs. Nat. _____

1st 24 hrs. after shot _____

Gas _____ Cu. Ft.

Dry Hole _____

Abandoned _____

Date

APR 7 1937 19S. J. LEWIS Scout

KANSAS

Map No. 71 Sec. 22 Twp. 11 R. 17^WWell No. 2-Bernie "C"Margay Company

Contractor

COMPLETED

SECTION PLAT

990 Ft. from N. Line990 Ft. from S. Line990 Ft. from E. Line

_____ Ft. from W. Line

	0		

Location _____

Rig up _____

Drilling and Remarks:

Pat 2383

RECORD

Cased _____ in., _____ ft.

Sand 511 3486

Gas _____

Oil _____

Total Depth 3489

PRODUCTION

1st 24 hrs. Nat. _____

1st 24 hrs. after shot _____

Gas _____ Cu. Ft.

Dry Hole _____

Abandoned _____

Date

MAY 19 1937 19 H. D. Hatfield Scout