


Section..... 22 Township..... 11 Range 17-W

Well Number..... 3 Bemis "C"

Company..... Margay Oil

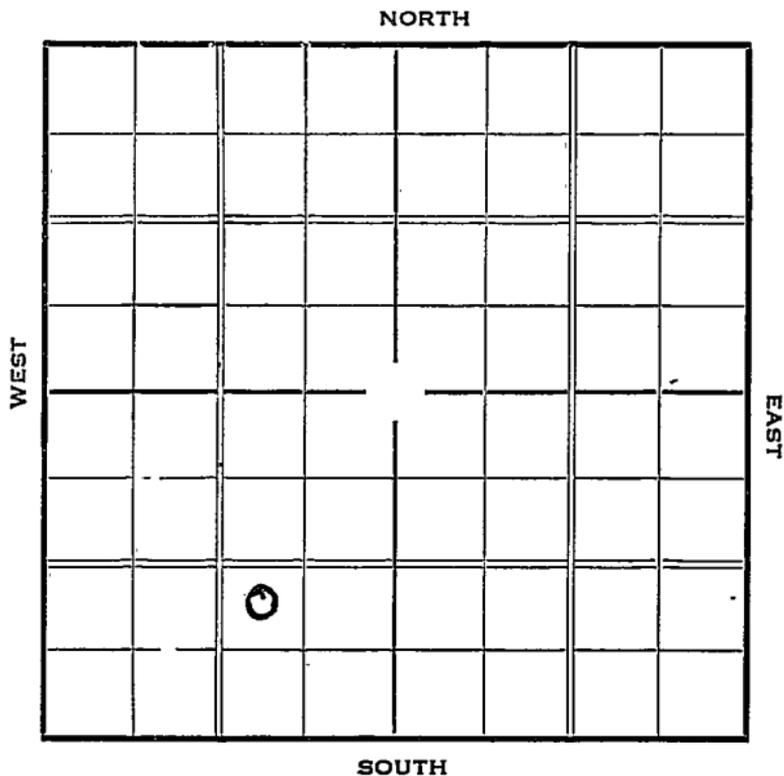

Sec. 22 Twp. 11 R. 17-W

Well No. #3 Bemis "C" Farm
Margay Oil Company


_____ Ft. from N. Line

990 Ft. from S. Line

990 Ft. from E. Line

_____ Ft. from W. Line

Elev. 2002

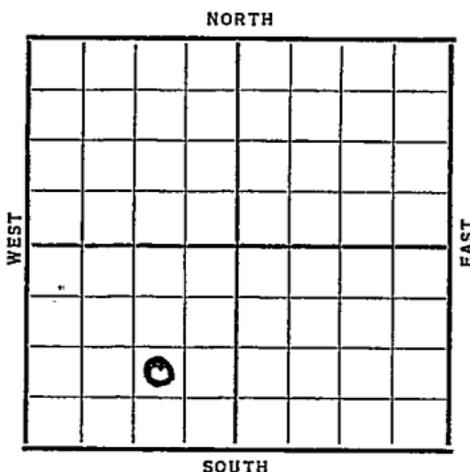

Date	REPORT
1937	
4/14	Location
4/23	Surface hole.
4/30	15" @ 53'. Drlg. 1230'.
5/7	Drlg. 3075'.
5/14	Simp. 3456'. S.O.
	Sil. 3467'. 7" @ 3465'.
	T.D. 3467'.
5/21	T.D. 3473'. H.F.O.
5/26	7" @ 3465'.
	Sil. 3467'.
	T.D. 3473'.
	Potential 2706 bbls.
	COMPLETED

Map No. _____ Sec. 22 Twp. 11 R. 17W

Well No. 3 Bemis "C"

Margay Oil Company
S J Contractor

SECTION PLAT

	6		

_____ Ft. from N. Line

990 Ft. from S. Line

990 Ft. from E. Line

_____ Ft. from W. Line

FIRST REPORT

Location ✓

Rig up _____

Drilling and Remarks:

RECORD

Cased _____ in., _____ ft.

Sand _____

Gas _____

Oil _____

Total Depth _____

PRODUCTION

1st 24 hrs. Nat. _____

1st 24 hrs. after shot _____

Gas _____ Cu. Ft.

Dry Hole _____

Abandoned _____

Date

APR 14 1937 19

S. J. LEWIS

Scout

✓

Ellis **KANSAS**

Map No. _____ Sec. 22 Twp. 11 R. 17^W

Well No. 3-Bemis "C"

Margay _____ Company
 _____ Contractor

COMPLETED

SECTION PLAT

_____ Ft. from N. Line

990 Ft. from S. Line

990 Ft. from E. Line

_____ Ft. from W. Line

	0		.

Location _____

Rig up _____

Drilling and Remarks:

Pot - 2706

RECORD

Cased 7 in., 3465 ft.

Sand 511 3467

Gas _____

Oil _____

Total Depth 3473'

PRODUCTION

1st 24 hrs. Nat. _____

1st 24 hrs. after shot _____

Gas _____ Cu. Ft.

Dry Hole _____

Abandoned _____

Date

MAY 26 1937

H. D. Hatfield

Scout